

GLADWIN COUNTY REMONUMENTATION

LAND CORNER RECORDATION CERTIFICATE
Filing Requirement of Act 74, Mich. P.A. 1970

USER 001 PAGE 164

For corners in

GLADWIN

(County)

Located in:

Corner Code #

1. Public Land Survey

T 18N R 1W

F - 5

2. Property Controlling
in Section

S

T R

3. Miscellaneous
Property in Sec.

S

T R

S

T R

4. Lot No. , Recorded Plat

5. Private Claims

STATE OF MICHIGAN
GLADWIN COUNTY
FILED -Remonumentation

17 OCT 97 1:18 P.M.

BONNIE K. HOUSE
REGISTER OF DEEDS

Register of Deeds Stamp & File Number

I, MARK R. ROBISON, in a field survey on April 17, 19 97 do hereby state that under requirements of P.A. 74, Michigan P.A. of 1970, the corner points mentioned in lines 1 and 2 above were in conformance with regulations and rules therefore as required in the current manual of survey instructions of the United States Department of the Interior, Bureau of Land Management or by a decree of a Court of Law and /or that the corner points mentioned in lines 3, 4 and 5 above were in conformance with the rules of the Michigan Board of Land Surveyors or by a Decree of a Court of Law; established, re-established, monumented, recovered, found as expressed below:

NOTE: Not more than 2 corners, all in the same town and range, may be recorded on this certificate.

A. Description of original monument and accessories and/or subsequent restoration:

1877 T. Gale Merrill
Set Post
Wit-(1)N1W 9 links 7" Cedar
(2)S10W 22 links 8" Balsam

1907 County Survey Records
Est 1/4 Post at proportional measurement
Wit-(3)N60E 44 links 16" Pine Stump

1995 Lapham survey & working dwg.
Fd 1/2" rerod at proportional measurement
Wit-(4)N05E 22.55' P.K. Cor Fence Post
(5)N30E 30.20' Fence Post
(6)S55E 40.25' 6" Poplar
(7)S15W 58.70' 12" Poplar

APPROVED LAND CORNER
P.A. 343 of 1990
Gladwin County

Co. Rep.

Date

B. Description of corner evidence found and/or method applied in restoring or reestablishing corner:

Found 1/2" x 18" rerod in centerline of county road 5'+/- West of newer fence corner & fence line to North. Found capped iron marked traverse point 33' South & brush line South. Found witnesses (4), (5) & (7) as recorded and measured. Set Gladwin County Re-mon from found iron and witnesses.

See dossier for detailed report.

C. Description of monument for corner and accessories established to perpetuate locating the position of the corner:


F-5: Corner common to Sections 9 & 16.
Set 5/8" x 36" rerod with Gladwin County Re-mon Cap marked P.S.#27458.

Witnesses:

N05E Corner Post, P.K. nail, 22.55'
N30E Fence Post, P.K. nail, 30.20'
S15W 12" Poplar, P.K. nail, 58.70'
N25W 12" Maple, nail & tag, 73.85'
S05E 6" Maple, nail & tag, 49.52'

Signed by

Surveyor's Michigan License No. 27458

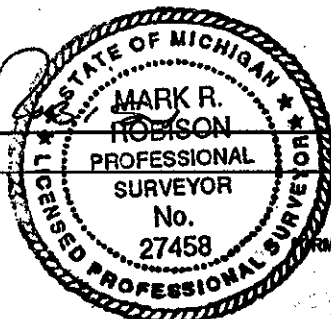

Date

SURVEY &
REMONUMENTATION

JAN 08 1998

SECTION