

SURVEY &  
REMONUMENTATION  
APR 07 1995  
COMMISSION

LAND CORNER RECORDATION CERTIFICATE  
Filing Requirement of Act 74, Mich. P.A. 1970

PAGE 58

For corners in GLADWIN  
(County)

Located In:

Corner Code K-1

STATE OF MICHIGAN  
GLADWIN COUNTY  
RECORDED

28 DEC 94 3:01 P.M.

BONNIE K. HOUSE  
REGISTER OF DEEDS

Register of Deeds Stamp & File Number

1. Public Land Survey T 18N R 1W K-1  
T     R      
T     R      
T     R      
2. Property Controlling S     T     R      
in Section S     T     R      
3. Miscellaneous S     T     R      
Property in Sec. S     T     R

4. Lot No.           , Recorded Plat             
5. Private Claims

I, PAUL B. LAPHAM, in a field survey on NOVEMBER, 19 94,  
do hereby certify that under requirements of P.A. 74, Michigan P.A. of 1970, the corner points mentioned  
in lines 1 and 2 above were in conformance with regulations and rules therefore as required in the  
current manual of survey instructions of the United States Department of the Interior, Bureau of Land  
Management or by a decree of a Court of Law and/or that the corner points mentioned in lines 3, 4 and 5  
above were in conformance with the rules of the Michigan Board of Land Surveyors or by a Decree of a  
Court of Law; established, re-established, monumented, re-monumented, recovered, found as  
expressed below:

**NOTE: Not more than 4 corners, all in the same town and range, may be recorded  
on this certificate.**

A. Description of original monument and accessories and/or subsequent restoration:

1877 T. GALE MERRILL  
SET POST  
WIT.-W. PINE 18" N62°W 24  
DO 26" N47°E 07

1976 SEDGMAN, SURVEY

1976 SEDGMAN, L.C.R.C. #148  
SET 1/2" BAR CAPPED  
WIT.-S05°W 28.00' CORNER FENCE POST  
N70°W 82.38' 8" BIRCH  
S70°E 129.56' 10" PINE

1989 WADE-TRIM- EDMANDS, WORKSHEET  
FOUND 5/8" IRON  
WIT.-S 32.5' TO FACE CORNER FENCE POST  
S.W. 87.75' TO N.W. CORNER (RED) CABIN  
N. 41.85' TO PK IN 8" PINE  
S.E. 142.1' TO W.N.W. COR. HOUSE #239

B. Description of corner evidence found and/or method applied in restoring or reestablishing corner:

FOUND 1/2" CAPPED IRON @ OF ROAD OPPOSITE FENCE TO SOUTH, OLD CORNER POST DOWN,  
SEARCHED-FOUND NO OTHER CORNER EVIDENCE.  
S.W. 87.95' TO N.W. COR. RED CABIN (GONE)- FOUNDATION ONLY MEAS. 88.05'  
S.E. 142.1' TO W.N.W. CORNER HOUSE #239 MEAS. 142.05'  
N. 41.85' TO PK IN 8" PINE MEAS. 41.75'  
SET CORNER FROM FOUND 1/2" CAPPED IRON & WITNESSES OF RECORD.

APPROVED LAND CORNER  
P.A. 345 of 1990  
Gladwin County

Co. Rep. John Meyer


Date 12-19-94

Accepted as best available evidence of the position of the original corner & replaced with Standard Monument.

Corner, K-1 was approved for remonumentation at a Peer Review Committee Meeting on 12/19, 19 94.

C. Description of monument for corner and accessories established to perpetuate locating the position of the corner:

K-1: Corner common to Sections 1 & 2  
SET 5/8" x 36" RE-ROD WITH GLADWIN COUNTY RE-MON CAP, MARKED P.S. #9433.  
S50°E N.W. COR. CABIN 142.05'  
N40°E 15" W. PINE - NAIL & TAG - 48.00'  
N5°W 8" J. PINE - NAIL & TAG - 41.75'  
S35°W N.W. COR. CONCRETE SLAB 88.05'

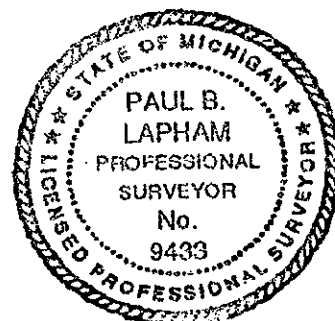

Signed by

Paul B. Lapham

Date

12-23-94

Surveyor's Michigan License No. 9433