

DEC 16 1996

GLADWIN COUNTY REMONUMENTATION

COMMISSION

LAND CORNER RECORDATION CERTIFICATE
Filing Requirement of Act 74, Mich. P.A. 1970

LIBER 001 PAGE 151

For corners in

GLADWIN (County)	Located In:	Corner Code #
1. Public Land Survey	T 20N R 1W	G - 5
	T R	
	T R	
	T R	
2. Property Controlling in Section	S T R	
	S T R	
3. Miscellaneous Property in Sec.	S T R	
	S T R	

STATE OF MICHIGAN
GLADWIN COUNTY
FILED-REMONUMENTATION

2 DEC 96 3:34 P.M.

RONNIE K. HOUSE
REGISTER OF DEEDS

Register of Deeds Stamp & File Number

4. Lot No. _____, Recorded Plat _____
5. Private Claims _____

I, MARK ROBISON, in a field survey on November, 19 96 do hereby state that under requirements of P.A. 74, Michigan P.A. of 1970, the corner points mentioned in lines 1 and 2 above were in conformance with regulations and rules therefore as required in the current manual of survey instructions of the United States Department of the Interior, Bureau of Land Management or by a decree of a Court of Law and/or that the corner points mentioned in lines 3, 4 and 5 above were in conformance with the rules of the Michigan Board of Land Surveyors or by a Decree of a Court of Law; established, re-established, monumented, recovered, found as expressed below:

NOTE: Not more than 2 corners, all in the same town and range, may be recorded on this certificate.

	A	B	C	D	E	F	G	H	I	J	K	L	M
1													
2	6		5		4		3		2		1		
3													
4	7		8		9		10		11		12		
5													
6	18		17		16		15		14		13		
7													
8	19		20		21		22		23		24		
9													
10	30		29		28		27		26		25		
11													
12	31		32		33		34		35		36		
13													

A. Description of original monument and accessories and/or subsequent restoration:

1856 GEO E ADAIR
OLD POST REESTABLISHED
WIT.-(1)W PINE 24 N85E 39
(2)W PINE 24 S60W 45
1969 PAUL LAPHAM
SET 5/8" X 18" IRON INTERSECTION
COUNTY ROAD FOR SEC. SUBD.
WIT.-(3)BASE STOP SIGN N45E 31.65
(4)BASE STOP SIGN N45W 37.30
(5)BASE STOP SIGN S45W 38.70
1976 P LAPHAM-WORK MAP & SEC SUBD

1978 P LAPHAM LCRC #208 FD 1/2" REROD
WIT.-(6)N50E 58.45 P.P.
(7)S45E 45.25 TELE. RISER
(8)N45E 31.05 STOP SIGN
(9)S45W 39.70 STOP SIGN
1978 P LAPHAM-FLATS
HIGHLANDERS REALM
EASTCHESTER REALM
1988 EDMANDS ENG-ROAD PLANS
WIT.-(10)NE 58.7 TO WIT TAG IN
UTILITY POLE 58.7

(11)SE 45.75 TO TOP C/L
BURIED CABLE BOX
(12)SW 41.5 TO SIGN POST
1991 P LAPHAM SURVEY FD 1/2" REROD
WIT.-(13)SAME AS (6)
(14)N50W TOP EAST CENTER 12" C.M.P.
(15)S30E 54.05 EAST CENTER 12" C.M.P.
(16)N30E 71.13 FENCE POST

B. Description of corner evidence found and/or method applied in restoring or reestablishing corner:

FOUND 1" X 12" BAR 0.5 BELOW SURFACE OF ASPHALT ROAD INTERSECTION IN C/L OF N-S ROAD, 6 1/2' NORTH OF E-W ROAD. SET GLADWIN RE-MON FROM FOUND IRON AND WITNESSES (6),(13)&(16)

APPROVED LAND OCCUPIER
P.A. 215 of 1959
Gladwin County


SEE DOSSIER FOR DETAILED REPORT.

Co. Rep. Mark R. Robison
Date 11/6/96

C. Description of monument for corner and accessories established to perpetuate locating the position of the corner:

G-5: CORNER COMMON TO SECTIONS 9, 10, 15 & 16
SET 5/8" X 36" REROD WITH GLADWIN COUNTY RE-MON CAP MARKED P.S.#27458 IN MONUMENT BOX.

WITNESSES:
N50E POWER POLE, SPIKE & CAP, 58.45' S20W 1 1/2" X 36" REROD 20' WEST C/L 81.52'
N30E 8" POST, N&T, 71.15' NORTH, P.K. NAIL, 2.0'
N45W 3" W. PINE CENTER, N&T, 82.02' EAST, P.K. NAIL, 2.0'

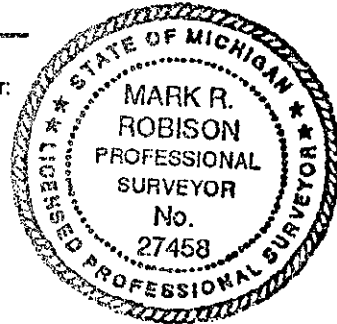

Signed by Mark R. Robison
Surveyor's Michigan License No. 27458

Date 11-29-96