

# SURVEY & REMONUMENTATION

NOV 12 1997

COMMISSION

## LAND CORNER RECORDATION CERTIFICATE Filing Requirement of Act 74, Mich. P.A. 1970

For corners in

Gogebic Located In: Corner Code #  
(County)

1. Public Land Survey T 43N R 38W G-6.7  
T     R     Other  
T     R     #005  
T     R      
T     R    

2. Property Controlling S     T     R      
in Section S     T     R    

3. Miscellaneous S     T     R      
Property in Sec. S     T     R    

Register's Office } ss.  
Gogebic County }

Received for record the  
27<sup>TH</sup> day of OCTOBER  
A. D. 1997 at 11:15 o'clock  
A m., and recorded in  
Liber 6 of GOLEBIC  
on page 249  
Ramona Collins, Deputy  
Register of Deeds

Register of Deeds Stamp & File Number

4. Lot No.    , Recorded Plat      
5. Private Claims    

Closing Corner Sec. 15 & 16, T43N, R38W

I, Gary L. Pisoni, in a field survey on June 26, 19 97 do hereby state that under requirements of P.A. 74, Michigan P.A. of 1970, the corner points mentioned in lines 1 and 2 above were in conformance with regulations and rules therefore as required in the current manual of survey instructions of the United States Department of the Interior, Bureau of Land Management or by a decree of a Court of Law and /or that the corner points mentioned in lines 3, 4 and 5 above were in conformance with the rules of the Michigan Board of Land Surveyors or by a Decree of a Court of Law; established, re-established, monumented, recovered, found as expressed below:

NOTE: Not more than 2 corners, all in the same town and range, may be recorded on this certificate.

A. Description of original monument and accessories and/or subsequent restoration:

Original corner established by Zelotes B. Searls, U.S. Deputy Surveyor on July 30, 1851.

Original corner: Wood post

Original bearing trees:

Sugar	24"	N 46°W	41 links (27.06 feet)
Sugar	22"	N 24°E	41 links (27.06 feet)

PEER GROUP APPROVED  
Richard L. Drach 10/8/97  
COUNTY REPRESENTATIVE

	A	B	C	D	E	F	G	H	I	J	K	L	M
1													
2	6		5		4		3		2		1		
3													
4	7		8		9		10		11		12		
5													
6	18		17		16		15		14		13		
7													
8	19		20		21		22		23		24		
9													
10	30		29		28		27		26		25		
11													
12	31		32		33		34		35		36		
13													

B. Description of corner evidence found and/or method applied in restoring or reestablishing corner:

No original corner evidence found.


Set corner by single proportionate measurement methods and on line between Mile Corner #11 and Mile Corner #11 1/2.

Corner Record Research on file with County Representative.

C. Description of monument for corner and accessories established to perpetuate locating the position of the corner:

At the corner position, I set a 2" diameter by 30" long split base aluminum pipe monument with a 3" cast aluminum cap, stamped to read: County Remonumentation, T43N, R38W, C.C., S-16, S-15, MICH/WIS, 1997, RLS-27457 from which I established the following new blazed and scribed bearing trees: (all measurements taken to a nail in side of tree)

Sugar Maple	8"	N 12°E	21.27 feet
Sugar Maple	12"	N 50°E	30.01 feet
Sugar Maple	14"	S 33°E	51.92 feet
Sugar Maple	8"	S 42°W	40.03 feet
Steel sign post		N 65°W	0.55 feet

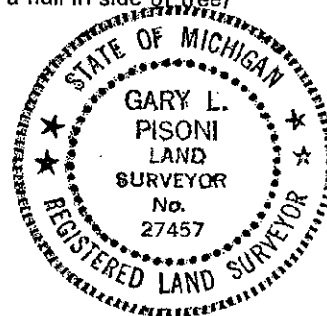

#97-01  
Signed by Gary L. Pisoni Date 7-15-97

Surveyor's Michigan License No. 27457

FORM APPROVED BY MICHIGAN STATE BOARD OF PROFESSIONAL SURVEYORS, JAN. 28, 1971  
REVISED MAY 14, 1975  
REVISED JAN., 1983  
REVISED OCT., 1995