

SURVEY & REMONUMENTATION

NOV 12 1997

COMMISSION

LAND CORNER RECORDATION CERTIFICATE Filing Requirement of Act 74, Mich. P.A. 1970

Register's Office } ss.
Gogetic County }

Received for record the
27th day of OCTOBER
A. D. 1997 at 11:15 o'clock
A m., and recorded in
Book 6 of CORNERS
on page 251
Ramona Collins, Deputy
Register of Deeds

Register of Deeds Stamp & File Number

For corners in

Gogetic
(County)

Located In:

Corner Code #

1. Public Land Survey

T43N R38W

E 4-5

T R

other

T R

007

T R

T R

2. Property Controlling
in Section

S T R

S T R

3. Miscellaneous
Property in Sec.

S T R

S T R


4. Lot No. _____, Recorded Plat _____

5. Private Claims _____

Closing Corner Sec. 8 & 9, T43N, R38W

I, Gary L. Pisoni, in a field survey on June 27, 1997 do hereby state that under requirements of P.A. 74, Michigan P.A. of 1970, the corner points mentioned in lines 1 and 2 above were in conformance with regulations and rules therefore as required in the current manual of survey instructions of the United States Department of the Interior, Bureau of Land Management or by a decree of a Court of Law and /or that the corner points mentioned in lines 3, 4 and 5 above were in conformance with the rules of the Michigan Board of Land Surveyors or by a Decree of a Court of Law; established, re-established, monumented, recovered, found as expressed below:

NOTE: Not more than 2 corners, all in the same town and range, may be recorded on this certificate.

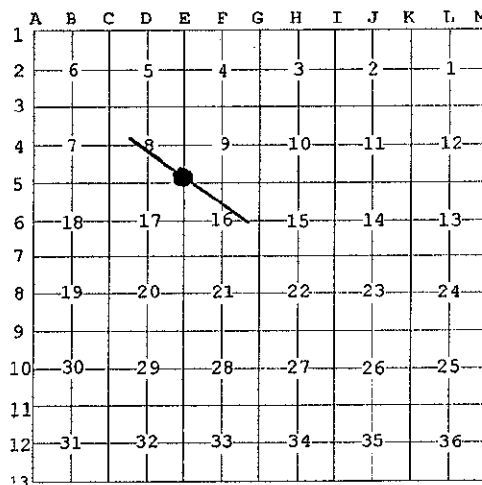

A. Description of original monument and accessories and/or subsequent restoration:

Original corner established by Zelotes B. Searls, U.S. Deputy Surveyor on July 30, 1851.

Original corner: Wood post

Original bearing trees:

Sugar	28"	N 41°E	25 links (16.50 feet)
Sugar	10"	N 03°W	55 links (36.30 feet)

PEER GROUP APPROVED
Richard L. Dean 10/8/97
COUNTY REPRESENTATIVE

B. Description of corner evidence found and/or method applied in restoring or reestablishing corner:

No evidence of original B.T.s found.


Set Closing Corner position by single proportionate measurement on line between Mile Corner #12 and Mile Corner #12 1/2 and from Closing Corner between Sections 9 and 16.

Corner Record Research on file with County Representative.

C. Description of monument for corner and accessories established to perpetuate locating the position of the corner:

At the corner position, I set a 2" diameter by 30" long split base aluminum pipe monument with a 3" cast aluminum cap, stamped to read: County Remonumentation, T43N, R38W, C.C., S-8, S-9, MICH/WIS, 1997, RLS-27457 from which I established the following new blazed and scribed bearing trees: (all measurements taken to a nail in side of tree)

Sugar Maple	10"	N 22°W	41.36 feet
Sugar Maple	12"	N 25°E	26.92 feet
Sugar Maple	8"	N 74°E	33.62 feet
Spruce	6"	N 57°W	13.27 feet
Steel sign post		S 42°E	0.74 feet

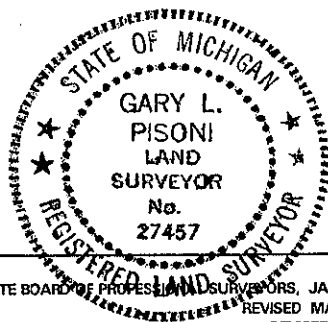

97-06

Signed by Gary L. Pisoni

Date 7-15-97

Surveyor's Michigan License No. 27457

FORM APPROVED BY MICHIGAN STATE BOARD OF PROFESSIONAL SURVEYORS, JAN. 28, 1971
REVISED MAY 14, 1975
REVISED JAN., 1983
REVISED OCT., 1995