

SURVEY & REMONUMENTATION

NOV 12 1997

COMMISSION

LAND CORNER RECORDATION CERTIFICATE Filing Requirement of Act 74, Mich. P.A. 1970

For corners in

<u>Gogebic</u> (County)	Located In:	Corner Code #
1. Public Land Survey	T <u>43N</u> R <u>38W</u>	EG 6-7
	T <u> </u> R <u> </u>	<u>Other</u>
	T <u> </u> R <u> </u>	<u>#009</u>
	T <u> </u> R <u> </u>	
2. Property Controlling in Section	S <u> </u> T <u> </u> R <u> </u>	
	S <u> </u> T <u> </u> R <u> </u>	
3. Miscellaneous Property in Sec.	S <u> </u> T <u> </u> R <u> </u>	
	S <u> </u> T <u> </u> R <u> </u>	

Register's Office }
Gogebic County } ss.

Received for record the
27th day of OCTOBER
A. D. 19 97 at 11:15 o'clock
A m., and recorded in
Liber 6 of CORNERS
on page 253
Ramona Collins, Deputy
Register of Deeds


Register of Deeds Stamp & File Number

4. Lot No. , Recorded Plat
5. Private Claims

Mile Corner # 11 1/2, Michigan-----Wisconsin State Line

I, Gary L. Pisoni, in a field survey on June 26, 19 97 do hereby state that under requirements of P.A. 74, Michigan P.A. of 1970, the corner points mentioned in lines 1 and 2 above were in conformance with regulations and rules therefore as required in the current manual of survey instructions of the United States Department of the Interior, Bureau of Land Management or by a decree of a Court of Law and /or that the corner points mentioned in lines 3, 4 and 5 above were in conformance with the rules of the Michigan Board of Land Surveyors or by a Decree of a Court of Law; established, re-established, monumented, recovered, found as expressed below:

NOTE: Not more than 2 corners, all in the same town and range, may be recorded on this certificate.

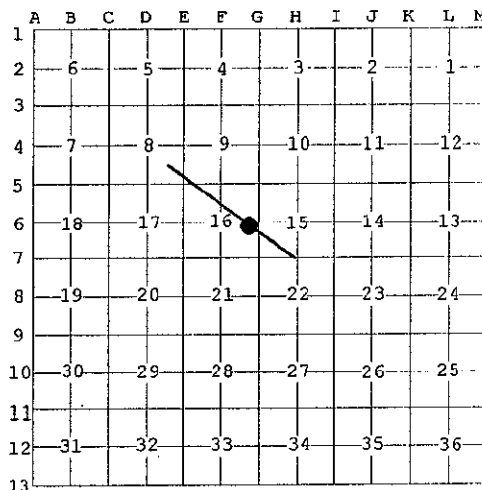

A. Description of original monument and accessories and/or subsequent restoration:

Corner established by William Burt in 1847.

Original bearing trees:

Cedar	8"	N 24°W	17 links (11.2 feet)
Black Ash	6"	S 02°E	18 links (11.88 feet)

PEER GROUP APPROVED
Richard P. Drach 10/9/97
COUNTY REPRESENTATIVE

Corner restored in 1928 by Earl G. Harrington from the original B.T. The cedar was a decayed cedar stump. He set a standard brass capped concrete monument and two new B.T.s.

Spruce	16"	N 66°50'E	54.7 links (36.1 feet)
Cedar	20"	S 01°E	26 links (17.16 feet)

B. Description of corner evidence found and/or method applied in restoring or reestablishing corner:

Recovered the 1928 standard brass capped concrete monument as described in Harrington's notes. The 1928 B.T. is now a 24" live cedar and no evidence of the Spruce B.T.

No evidence remains of the 1847 B.T.s.

Corner Record Research on file with County Representative.


Found bearing trees referencing Mile Corner position:

Balsam	8"	S 24°E	29.45 feet
Maple	12" (dbl)	S 55°W	20.75 feet
Balsam	8"	N 34°W	11.11 feet
Steel sign post		S 04°W	0.95 feet

C. Description of monument for corner and accessories established to perpetuate locating the position of the corner:

From the above described concrete monument, I established the following:

Ash	7"	N 80°E	8.94 feet
-----	----	--------	-----------

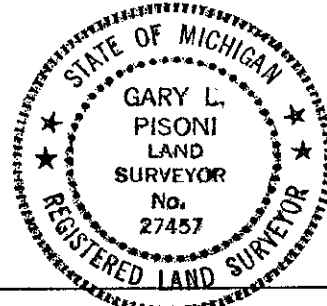

97-08
Signed by Gary L. Pisoni Date 7-15-97

Surveyor's Michigan License No. 27457