

LAND CORNER RECORDATION CERTIFICATE  
Filing Requirement of Act 74, Mich. P.A. 1970

Register's Office  
Gogebic County ss.

For corners in

Gogebic  
(County)

Located in:

Corner Code: #

1. Public Land Survey

T 44N R 41W

E-F, 3a

T R

002

T R

002

T R

002

2. Property Controlling  
in Section

S T R

S T R

R 10

3. Miscellaneous  
Property in Sec.

S T R

S T R

10/10/98

Received for record the  
18<sup>th</sup> day of APRIL  
A. D. 1994 at 1:20 o'clock  
P. M., and recorded in  
Liber 5 of CORNER  
on page 32

Betty L. Linn, Deputy  
Register of Deeds

Register of Deeds Stamp & File Number

4. Lot No.

Record

PEER GROUP

Approved

5. Private Claims

Richard L. Dredin

4/11/94

I, Gary L. Pisoni, in a field survey on December 20, 1993, do hereby certify that under requirements of P.A. 74, Michigan P.A. of 1970, the corner points mentioned in lines 1 and 2 above were in conformance with regulations and rules therefore as required in the current manual of survey instructions of the United States Department of the Interior, Bureau of Land Management or by a decree of a Court of Law and/or that the corner points mentioned in lines 3, 4 and 5 above were in conformance with the rules of the Michigan Board of Land Surveyors or by a Decree of a Court of Law; established, re-established, monumented, re-monumented, recovered, found as expressed below.

NOTE: Not more than 4 corners, all in the same town and range, may be recorded on this certificate.

A. Description of original monument and accessories and/or subsequent restoration:

Original Corner established by Algernon Merryweather, U.S. Deputy Surveyor on July 7, 1852.

Original Corner: Cedar Corner Tree 12" dia.

Original Bearing Tree:

Hemlock 24" S 30° E 22 links (14.52 feet)

B. Description of corner evidence found and/or method applied in restoring or reestablishing corner:

No original corner evidence found. Found a 1" dia. iron pipe located on the West shore of Cisco Lake marking corner position set by H. S. Tuttle.


H.S. Tuttle used the iron pipe for numerous lot surveys in Section 9 along the West shore of the Cisco Lake channel. I accept the iron pipe as the best available evidence for restoring the corner position.

Placed 3/4" dia. rod monument inside of iron pipe.

C. Description of monument for corner and accessories established to perpetuate locating the position of the corner:

At the corner position, I set a 3/4" outside diameter by 3 feet long aluminum rod monument with a 3" cast aluminum cap, stamped to read: T44N, R41W, S-4, S-9, M.C., 1993, RLS-27457 from which I established the following new blazed and scribed bearing trees: (all measurements taken to a nail in side of tree)

White Spruce	5"	N 26° W	14.09 feet
Hemlock	13"	S 56° E	15.40 feet
Hemlock	16"	S 73° W	13.62 feet
Steel Sign Post		S 42° W	0.93 feet

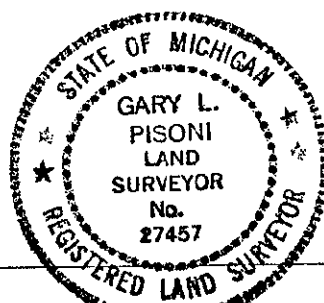

Signed by

Gary L. Pisoni

Date 3-22-94

Surveyor's Michigan License No. 27457