

LAND CORNER RECORDATION CERTIFICATE  
Filing Requirement of Act 74, Mich. P.A. 1970

For corners in

Gogebic  
(County)

Located In:

Corner Code #

1. Public Land Survey  
2. Property Controlling  
in Section  
3. Miscellaneous  
Property in Sec.

T 44N R 41W  
T R  
T R  
T R

G-3b, 4  
006  
006  
R.R.  
10/18/98  
Approved  
5/25/94

PEER GROUP

Richard J. Brown

Register's Office  
Gogebic County ss.

Received for record the  
1<sup>st</sup> day of June  
A. D. 1994 at 1:45 o'clock  
P. m., and recorded in  
Liber 5 of CORNERS  
on page 61  
Richard J. Brown  
Register of Deeds

Register of Deeds Stamp & File Number

4. Lot No. , Recorded Plat  
5. Private Claims

South Meander Corner between Sections 9 and 10 on the South  
shore of Thousand Island Lake.

I, Gary L. Pisoni in a field survey on December 20, 19 93,  
do hereby certify that under requirements of P.A. 74, Michigan P.A. of 1970, the corner points mentioned  
in lines 1 and 2 above were in conformance with regulations and rules therefore as required in the  
current manual of survey instructions of the United States Department of the Interior, Bureau of Land  
Management or by a decree of a Court of Law and/or that the corner points mentioned in lines 3, 4 and 5  
above were in conformance with the rules of the Michigan Board of Land Surveyors or by a Decree of a  
Court of Law; established, re-established, monumented, re-monumented, recovered, found as  
expressed below:

NOTE: Not more than 4 corners, all in the same town and range, may be recorded  
on this certificate.

A. Description of original monument and accessories and/or subsequent restoration:

Original corner established by Algernon Merryweather, U.S. Deputy Surveyor on July 3, 1852.  
Original corner: 10" Cedar corner tree.  
Original Bearing tree:  
Hemlock 8" S 30°E 3 links (1.98 feet)

18.40 CHS. SOUTH

B. Description of corner evidence found and/or method applied in restoring or reestablishing corner:


No original corner evidence found. Corner position found marked by a 5/8" x 32" iron  
pin. Donald D. Lappala R.L.S. found a wood post marking corner position in the 1970's  
and replaced wood post with iron pin as described above. Iron pin has been used for  
lot surveys in the immediate area. I accept the iron pin as the best available  
evidence for restoring the corner position.

Placed aluminum pipe monument over the top of iron pin as described below.

C. Description of monument for corner and accessories established to perpetuate locating the position of the corner:

At the corner position, I set a 2" diameter by 30" long split base aluminum pipe  
monument with a 3" cast aluminum cap, stamped to read: T44N, R41W, M.C., S-9,  
S-10, 1993, RLS- 27457 from which I established the following new blazed and  
scribed bearing trees: (all measurements taken to a nail in side of tree)

Balsam	8"	N 42°E	15.31 feet
Balsam	5"	S 82°E	22.62 feet
Cedar	9	S 36°W	43.60 feet
Steel Sign Post		S 05°E	0.71 feet

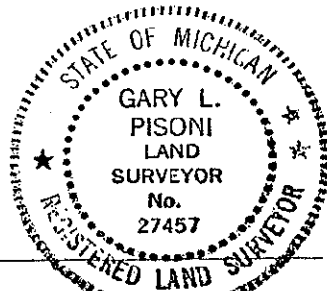

Signed by Gary L. Pisoni

Date 4-1-94

Surveyor's Michigan License No. 27457