

LAND CORNER RECORDATION CERTIFICATE
Filing Requirement of Act 74, Mich. P.A. 1970

Register's Office }
Gogebic County } ss.

Received for record the
18th day of April
A. D. 1994 at 1:20 o'clock
P. m., and recorded in
Liber 5 of CORNERS
on page 31.
Betty L. Larkin, Deputy
Register of Deeds

Register of Deeds Stamp & File Number

For corners in

Gogebic
(County)

Located In:

Corner Code ##

- | | | | | | |
|------------------------------------|---|-----|---|-----------|----------|
| 1. Public Land Survey | T | --- | R | --- | 007 |
| | T | --- | R | --- | R & W |
| | T | --- | R | --- | 10/18/98 |
| | T | --- | R | --- | |
| 2. Property Controlling in Section | S | 8 | T | 44N R 41W | E, 3-4 |
| | S | --- | T | --- | 007 |
| 3. Miscellaneous Property in Sec. | S | --- | T | --- | |
| | S | --- | T | --- | |

4. Lot No. _____, Recorded Plat _____
5. Private Claims _____

PEER GROUP Approved

Richard L. Dralun 4/7/94

I, Gary L. Pisoni, in a field survey on February 11, 1994, do hereby certify that under requirements of P.A. 74, Michigan P.A. of 1970, the corner points mentioned in lines 1 and 2 above were in conformance with regulations and rules therefore as required in the current manual of survey instructions of the United States Department of the Interior, Bureau of Land Management or by a decree of a Court of Law and/or that the corner points mentioned in lines 3, 4 and 5 above were in conformance with the rules of the Michigan Board of Land Surveyors or by a Decree of a Court of Law; established, re-established, monumented, re-monumented, recovered, found as expressed below:

NOTE: Not more than 4 corners, all in the same town and range, may be recorded on this certificate.

	A	B	C	D	E	F	G	H	I	J	K	L	M
2	6	5	4	3	2	1							
3													
4	7	8	9	10	11	12							
5													
6	18	17	16	15	14	13							
7													
8	19	20	21	22	23	24							
9													
10	30	29	28	27	26	25							
11													
12	31	32	33	34	35	36							
13													

A. Description of original monument and accessories and/or subsequent restoration:

Original corner established by Algernon Merryweather, U.S. Deputy Surveyor on July 7, 1852.
Original corner: Wood Post
Original bearing trees:
White Pine 4" N 50° W 17 links (11.22 feet)
Birch 6" N 15° W 22 links (14.52 feet)

B. Description of corner evidence found and/or method applied in restoring or reestablishing corner:

No original corner evidence found.


Corner restored on the North shore of Gray Lake and on line between the NE corner of Section 8 and the South Meander Corner between Sections 8 and 9 on the South shore of Gray Lake.

Meander corner is 15 feet from waters edge.

C. Description of monument for corner and accessories established to perpetuate locating the position of the corner:

At the corner position, I set a 2" diameter by 30" long split base aluminum pipe monument with a 3" cast aluminum cap, stamped to read: T44N, R41W, S-8, S-9, M.C., 1993, RLS- 27457 from which I established the following new blazed and scribed bearing trees: (all measurements taken to a nail in side of tree)

Hemlock	10"	S 69° E	10.68 feet
Red Maple	5"	N 53° W	14.55 feet
Black Spruce	9"	S 55° W	33.23 feet
Steel Sign Post		South	1.01 feet

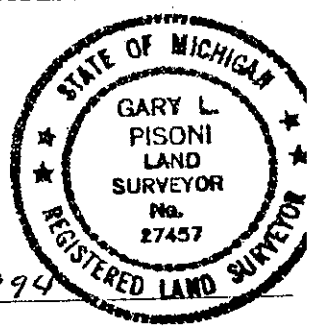

Signed by Gary L. Pisoni Date March 11th 1994
Surveyor's Michigan License No. 27457