

Register's Office } ss.
Gogebic County }
LAND CORNER RECORDATION CERTIFICATE
Filing Requirement of Act 74, Mich. P.A. 1970

For corners in

Gogebic
(County)

Located In:

Corner Code =#

Received for record the

18TH day of APRIL

A. D. 1994 at 1:20 o'clock

P m., and recorded in

Liber 5 of GOGBIC

on page 29

Betty Saari Deputy
Register of Deeds

Register of Deeds Stamp & File Number

- | | | |
|------------------------------------|---|-----------------|
| 1. Public Land Survey | T <u>44N</u> R <u>41W</u> | <u>C-4b,5</u> |
| | T <u> </u> R <u> </u> | <u>009</u> |
| | T <u> </u> R <u> </u> | <u> </u> |
| | T <u> </u> R <u> </u> | <u>009</u> |
| 2. Property Controlling in Section | S <u> </u> T <u> </u> R <u> </u> | <u>RLS</u> |
| | S <u> </u> T <u> </u> R <u> </u> | <u>10/18/98</u> |
| 3. Miscellaneous Property in Sec. | S <u> </u> T <u> </u> R <u> </u> | <u> </u> |
| | S <u> </u> T <u> </u> R <u> </u> | <u> </u> |

4. Lot No. , Recorded BEER GROUP Approved
5. Private Claims Richard L. Pisoni 4/7/94

I, Gary L. Pisoni, in a field survey on December 30, 19 93, do hereby certify that under requirements of P.A. 74, Michigan P.A. of 1970, the corner points mentioned in lines 1 and 2 above were in conformance with regulations and rules therefore as required in the current manual of survey instructions of the United States Department of the Interior, Bureau of Land Management or by a decree of a Court of Law and/or that the corner points mentioned in lines 3, 4 and 5 above were in conformance with the rules of the Michigan Board of Land Surveyors or by a Decree of a Court of Law; established, re-established, monumented, re-monumented, recovered, found as expressed below:

NOTE: Not more than 4 corners, all in the same town and range, may be recorded on this certificate.

A. Description of original monument and accessories and/or subsequent restoration:

Original Corner established by Algernon Merryweather, U.S. Deputy Surveyor on July 11, 1852.
Original Corner: Willow Corner Tree 4" dia.
Original Bearing Tree:
Willow 4" S 10°W 6 links (3.96 feet)

B. Description of corner evidence found and/or method applied in restoring or reestablishing corner:


No original corner evidence found. I restored the meander corner position on the South shore of Brown Lake on line between the East quarter corner and the Southeast Section corner of Section 7.

Monument located 8 feet from edge of shoreline.

C. Description of monument for corner and accessories established to perpetuate locating the position of the corner:

At the corner position, I set a 3/4" outside diameter by 3 feet long aluminum rod monument with a 3" cast aluminum cap, stamped to read: T44N, R41W, M.C., S-7, S-8, 1992, RLS- 27457 from which I established the following new blazed and scribed bearing trees: (all measurements taken to a nail in side of tree)

Cedar	15"	N 81°E	23.39 feet
Cedar	14"	S 54°E	30.28 feet
Hemlock	13"	S 10°W	40.81 feet
Steel Sign Post		West	1.02 feet

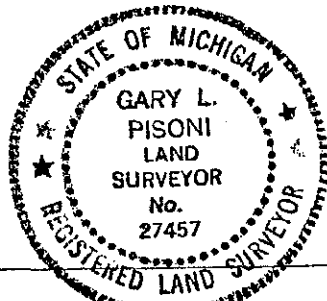

Signed by Gary L. Pisoni

Date 3-22-94

Surveyor's Michigan License No. 27457