

Register's Office } ss.  
LAND CORNER RECORDATION CERTIFICATE Gogebic County  
Filing Requirement of Act 74, Mich. P.A. 1970


For corners in  
Gogebic (County)  
Located In: Corner Code #  
1. Public Land Survey T 44N R 41W A-5, 3  
T R 012  
T R 012  
T R R & D  
2. Property Controlling PEER GROUP 10/18/98  
in Section S 1 R 1 Approved  
3. Miscellaneous S T R  
Property in Sec. Richard L. Pisoni 5/25/94  
4. Lot No. , Recorded Plat  
5. Private Claims

Received for record the  
15<sup>th</sup> day of JUNE  
A. D. 1994 at 1:45 o'clock  
P m., and recorded in  
Liber 5 of CORNERS  
on page 60  
Richard J. Brown Jr.  
Register of Deeds

Register of Deeds Stamp & File Number

Closing corner between Sections 13 and 18 on Mich/Wisc State Line

I, Gary L. Pisoni, in a field survey on February 17, 1994  
do hereby certify that under requirements of P.A. 74, Michigan P.A. of 1970, the corner points mentioned  
in lines 1 and 2 above were in conformance with regulations and rules therefore as required in the  
current manual of survey instructions of the United States Department of the Interior, Bureau of Land  
Management or by a decree of a Court of Law and/or that the corner points mentioned in lines 3, 4 and 5  
above were in conformance with the rules of the Michigan Board of Land Surveyors or by a Decree of a  
Court of Law; established, re-established, monumented, re-monumented, recovered, found as  
expressed below:

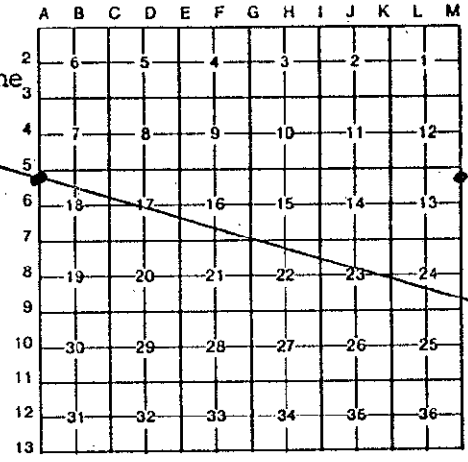

NOTE: Not more than 4 corners, all in the same town and range, may be recorded on this certificate.

A. Description of original monument and accessories and/or subsequent restoration:


Original corner established by William A. Burt, U.S. Deputy Surveyor in July, 1847.  
Original corner: Cedar Post  
Original Bearing Trees:  
White Pine 7" N 12° E 24 links (15.84 feet)  
Tamarack 8" N 15° W 42 links (27.72 feet)

B. Description of corner evidence found and/or method applied in restoring or reestablishing corner:

No original corner evidence found.  
Corner restored by single proportionate measurement along the Mich/Wisc State boundary line  
on line between Mile Corner #31 and Mile Corner #31½.

C. Description of monument for corner and accessories established to perpetuate locating the position of the corner:

At the corner position, I set a 2" diameter by 30" long split base aluminum pipe  
monument with a 3" cast aluminum cap, stamped to read: T44N, R42W, R41W, S-13,  
S-18, Mich., Wis., C.C., 1991, RLS 27457 from which I established the following  
new blazed and scribed bearing trees: (all measurements taken to a nail in side of tree)  
Black Spruce 5" S 06° E 3.69 feet  
Cedar 9" N 79° W 26.95 feet  
Hemlock 17" N 06° E 37.35 feet  
Steel sign post N 70° E 1.10 feet

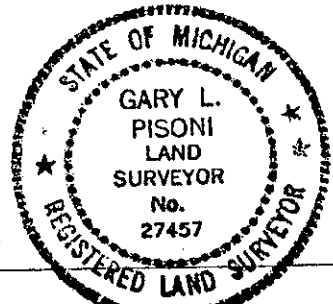

Signed by Gary L. Pisoni Date 4-12-94  
Surveyor's Michigan License No. 27457