

LAND CORNER RECORDATION CERTIFICATE
Filing Requirement of Act 74, Mich. P.A. 1970

For corners in

Gogebic
(County)

Located In:

Corner Code =#

1. Public Land Survey Sec. 15 T 44N R 41W
T R
T R
T R
2. Property Controlling S T R
in Section S T R
3. Miscellaneous S T R
Property in Sec. S T R

H - I - 7
015
015
RRD
10/10/98

Register's Office } ss.
Gogebic County }

Received for record the
16TH day of SEPTEMBER
A. D. 1994 at 3:20 o'clock
P m., and recorded in
Liber 5 of CORNERS
on page 94

Ramona Collins, Deputy
Register of Deeds

Register of Deeds Stamp & File Number

4. Lot No. , Recorded Plat
5. Private Claims

Meander corner common to Sections 15 & 22, T44N-R41W.

I, John R. Garske, in a field survey on February 10, 1994, do hereby certify that under requirements of P.A. 74, Michigan P.A. of 1970, the corner points mentioned in lines 1 and 2 above were in conformance with regulations and rules therefore as required in the current manual of survey instructions of the United States Department of the Interior, Bureau of Land Management or by a decree of a Court of Law and/or that the corner points mentioned in lines 3, 4 and 5 above were in conformance with the rules of the Michigan Board of Land Surveyors or by a Decree of a Court of Law; established, re-established, monumented, re-monumented, recovered, found as expressed below:

NOTE: Not more than 4 corners, all in the same town and range, may be recorded on this certificate.

A. Description of original monument and accessories and/or subsequent restoration:

Survey by Algernon Merryweather on July 2, 1852; meander corner consisting of a 4" cedar corner tree from which a 9" hemlock bears N20°E, 13 links (8.58 feet).

PEER GROUP

Approved

Richard L. Drach

9/14/94

B. Description of corner evidence found and/or method applied in restoring or reestablishing corner:

No original survey information could be found. We found a 2" iron pipe at the corner position which is shown on a 1927 survey by a D.S. Burnett; a 1960 survey map by W. Tuttle; a 1972 survey by Joseph Harding and a 1991 survey by Gary Pisoni. The iron pipe I found is historically in the correct location and is referenced in many deeds of record. It is in a harmonious location being used and accepted by area residents.

Record research on file with County Register of Deeds office.

C. Description of monument for corner and accessories established to perpetuate locating the position of the corner:

Set 3/4" x 30" rebar inside existing pipe with a 3 1/4" stamped aluminum county tablet.
Established the following bearing trees and reference objects:


6" cedar - N11°E - 19.10 feet
8" cedar - S04°E - 7.41 feet
6" balsam - N52°W - 4.63 feet
Steel Sign post - due east - 1.85 feet

Signed by

John R. Garske

Date

Surveyor's Michigan License No. 28410

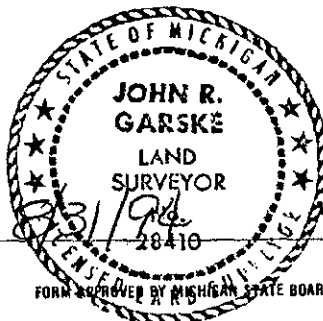

FORM APPROVED BY MICHIGAN STATE BOARD OF LAND SURVEYORS, JAN. 28, 1971
REVISED MAY 14, 1975
REVISED JAN., 1983