

LAND CORNER RECORDATION CERTIFICATE  
Filing Requirement of Act 74, Mich. P.A. 1970

For corners in

Gogebic

(County)

Located In:

Corner Code 77

1. Public Land Survey

T 45N R 40W

G-H, 3e

T R

007

T R

T R

2. Property Controlling  
in Section

S T R

S T R

3. Miscellaneous

S T R

Property in Sec.

S T R

4. Lot No. , Recorded Plat

5. Private Claims

East Meander Corner between Section 3 and Section 10.

I, Gary L. Pisoni, in a field survey on December 14, 19 92, do hereby certify that under requirements of P.A. 74, Michigan P.A. of 1970, the corner points mentioned in lines 1 and 2 above were in conformance with regulations and rules therefore as required in the current manual of survey instructions of the United States Department of the Interior, Bureau of Land Management or by a decree of a Court of Law and/or that the corner points mentioned in lines 3, 4 and 5 above were in conformance with the rules of the Michigan Board of Land Surveyors or by a Decree of a Court of Law; established, re-established, monumented, re-monumented, recovered, found as expressed below:

NOTE: Not more than 4 corners, all in the same town and range, may be recorded on this certificate.

A. Description of original monument and accessories and/or subsequent restoration:

Original corner established by Wells Burt, U.S. Deputy Surveyor on July 27, 1851.

Original corner: Wood post

Original bearing trees:

Cedar	8"	N 25° E	5 links (3.30 feet)
Cedar	8"	S 60° E	17 links (11.22 feet)

B. Description of corner evidence found and/or method applied in restoring or reestablishing corner:

No original corner evidence found. Corner restored by single proportionate measurement methods on line between the Northwest corner of Section 10 and the North quarter corner.

C. Description of monument for corner and accessories established to perpetuate locating the position of the corner:

At the corner position, I set a 3/4" outside diameter by 4 feet long aluminum rod monument with a 3" cast aluminum cap, stamped to read: T45N, R40W, M.C., S-3, S-10, 1992, R.L.S. 27457; from which I established the following new blazed and scribed bearing trees: (all measurements taken to a nail in side of tree)

Red Maple	12"	N 27° E	18.83 feet
Cedar	12"	S 68° E	25.45 feet
White Pine	14"	N 41° W	29.39 feet
Steel sign post		South	1.08 feet

Register's Office  
Gogebic County ss.

Received for record the

11 day of AUGUST

A. D. 1992 at 9:15 o'clock

A m., and recorded in

Liber 4 of CORNERS

on page 250.

Betty L. Lavin Deputy  
Register of Deeds

Register of Deeds Stamp & File Number

	A	B	C	D	E	F	G	H	I	J	K	L	M
2	6	5	4	3	2								
3													
4	7	8	9	10	11	12							
5													
6	13	17	16	15	14	13							
7													
8	19	20	21	22	23	24							
9													
10	30	29	28	27	26	25							
11													
12	31	32	33	34	35	36							
13													


PEER GROUP APPROVED

Richard E. Drabn 1/20/94  
COUNTY REPRESENTATIVE

C. Description of monument for corner and accessories established to perpetuate locating the position of the corner:

At the corner position, I set a 3/4" outside diameter by 4 feet long aluminum rod monument with a 3" cast aluminum cap, stamped to read: T45N, R40W, M.C., S-3, S-10, 1992, R.L.S. 27457; from which I established the following new blazed and scribed bearing trees: (all measurements taken to a nail in side of tree)

Red Maple	12"	N 27° E	18.83 feet
Cedar	12"	S 68° E	25.45 feet
White Pine	14"	N 41° W	29.39 feet
Steel sign post		South	1.08 feet

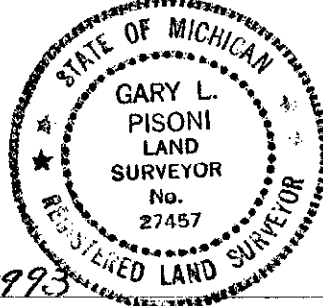

Signed by Gary L. Pisoni

Date August 6th, 1993

Surveyor's Michigan License No. 27457

U.S.F.S. #E-13,14e

250