

LAND CORNER RECORDATION CERTIFICATE
Filing Requirement of Act 74, Mich. P.A. 1970

For corners in
Gogebic
(County)

Located In:

Corner Code --#

1. Public Land Survey

T 44-45N R 41W

D, E-13

T R

007

T R

T 44N R 41W

017

2. Property Controlling
in Section

S T R

S T R

3. Miscellaneous
Property in Sec.

S T R

S T R

Register's Office } ss.
Gogebic County }

Received for record the
29TH day of SEPTEMBER
A. D. 1993 at 9:15 o'clock
A m., and recorded in
Liber 4 of CORNERS
on page 254 278

Betty Isaac Deputy
Register of Deeds

Register of Deeds Stamp & File Number

4. Lot No. , Recorded Plat PEER GROUP Approved
5. Private Claims

Richard L. Wzahn

1/20/94

I, Gary L. Pisoni, in a field survey on Sept. 15, 1992, do hereby certify that under requirements of P.A. 74, Michigan P.A. of 1970, the corner points mentioned in lines 1 and 2 above were in conformance with regulations and rules therefore as required in the current manual of survey instructions of the United States Department of the Interior, Bureau of Land Management or by a decree of a Court of Law and/or that the corner points mentioned in lines 3, 4 and 5 above were in conformance with the rules of the Michigan Board of Land Surveyors or by a Decree of a Court of Law; established, re-established, monumented, re-monumented, recovered, found as expressed below:

NOTE: Not more than 4 corners, all in the same town and range, may be recorded on this certificate.

A. Description of original monument and accessories and/or subsequent restoration:

Original corner established by William A. Burt, U.S. Deputy Surveyor in 1847.

Original corner: Cedar Post

Original bearing trees:

Cedar	8"	N 08° E	42 links (27.72 feet)
Cedar	7"	N 55° W	6 links (3.96 feet)

B. Description of corner evidence found and/or method applied in restoring or reestablishing corner:

No original corner evidence found. At the corner position, found an old wood post and rebar pin which previously set next to wood post as meander corner. I accepted the wood post as the best available evidence for restoring the corner position.

Monument is 16 feet from waters edge.

C. Description of monument for corner and accessories established to perpetuate locating the position of the corner:

At the corner position, I replaced the wood post and rebar pin and set a 2" diameter by 30" long split base aluminum pipe monument with a 3" cast aluminum cap, stamped to read: T45N, R41W, S-32, S-5, M.C., T44N, 1992, RLS 27457 from which I established the following new blazed and scribed bearing trees: (all measurements taken to a nail in side of tree)

Sugar Maple	8"	N 15° E	16.97 feet
Balsam	9"	S 53° W	14.50 feet
Sugar Maple	14"	N 83° W	30.18 feet
Steel sign post		West	0.57 feet

Signed by Gary L. Pisoni


Date Sept. 20th 1993

Surveyor's Michigan License No. 27457

U.S.F.S. #Z-8,9

254 278

	A	B	C	D	E	F	G	H	I	J	K	L	M
2	6		5		4		3		2		1		
3													
4	7		8		9		10		11		12		
5													
6	18		17		16		15		14		13		
7													
8	19		20		21		22		23		24		
9													
10	30		29		28		27		26		25		
11													
12	31		32		33		34		35		36		
13													

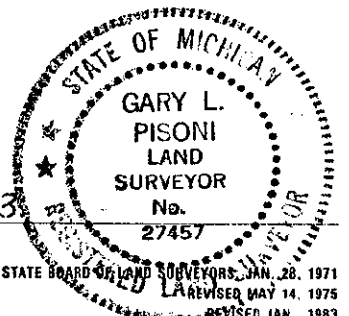

FORM APPROVED BY MICHIGAN STATE BOARD OF LAND SURVEYORS, JAN. 28, 1971
REVISED MAY 14, 1975
REVISED JAN., 1983