

SURVEY & REMONUMENTATION

AUG 08 1997

COMMISSION

LAND CORNER RECORDATION CERTIFICATE Filing Requirement of Act 74, Mich. P.A. 1970

For corners in Gogebic
(County)

Located In:

Corner Code #

- | | | | | |
|------------------------------------|-------------------------|-----------------|-------|-----|
| 1. Public Land Survey | Section 4 | T 45N R 41W | EF-13 | 008 |
| | | T 44N R 41W | EF-1 | 018 |
| | | T _____ R _____ | | |
| | | T _____ R _____ | | |
| 2. Property Controlling in Section | S _____ T _____ R _____ | | | |
| | S _____ T _____ R _____ | | | |
| 3. Miscellaneous | S _____ T _____ R _____ | | | |
| Property in Section | S _____ T _____ R _____ | | | |

4. Lot No. _____, Recorded Plat _____
5. Private Claims _____

Meander corner sections 33 and 4 T44-45N R41W.

I, John R. Garske, in a field survey on June 17, 1997, do hereby certify that under requirements of P.A. 74, Michigan P.A. of 1970, the corner points mentioned in lines 1 and 2 above were in conformance with regulations and rules therefore as required in the current manual of survey instructions of the United States Department of the Interior, Bureau of Land Management or by a decree of a Court of Law and/or that the corner points mentioned in lines 3, 4 and 5 above were in conformance with the rules of the Michigan Board of Professional Surveyors or by a Decree of a Court of Law; established, re-established, monumented, re-monumented, recovered, found as expressed below:

NOTE: Not more than 4 corners, all in the same town and range, may be recorded on this certificate.

A. Description of original monument and accessories and/or subsequent restoration:

On July 29, 1847, William Burt, D.S. established the corner and the following bearing trees:
12" Cedar N47°E 6 links
9" Cedar S79°W 18 links

In 1980 Richard Drahn, R.L. S. #21564 found a Michigan Conservation Department monument and established witness objects (see Section C below).
Recorded Liber 3, page 289.


B. Description of corner evidence found and/or method applied in restoring or reestablishing corner:

I found a monument and witness objects as noted in Richard Drahn's Certificate. The corner was set by Shadko, a surveyor for the Michigan Conservation Dept. in 1943. He found a 4"x 4" cedar stake inscribed 1225 ft. to the E 1/4 corner as shown in his notes I received from the MDNR surveyor Steve Syszkoski.

Corner research on file.

C. Description of monument for corner and accessories established to perpetuate locating the position of the corner:

Block foundation corner of building	-S06°W	-44.00 ft. (existing)
Sign rail	N46°W	0.56 ft. (existing)
Sign rail	N82°E	49.37 ft. (existing)
5/8" x 24" rebar	S86°E	156.86 ft. (new)
6" Red pine	N13°E	10.99 ft. (new)
Light Pole	S31°W	18.27 ft. (new)

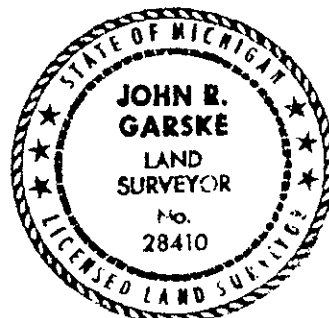

Signed by John R. Garske
Surveyor's Michigan License No. 28410

Date 7/15/97

FORM APPROVED BY MICHIGAN STATE BOARD OF PROFESSIONAL SURVEYORS, JAN. 28, 1971
REVISED MAY 14, 1975
REVISED JAN., 1983

Register's Office }
Gogebic County } ss.

Received for record the
16th day of JULY

A. D. 1997 at 1:40 o'clock
P m., and recorded in

Liber 6 of CORNERS
on page 163

Colleen M. Kibak
Deputy Register of Deeds

Register of Deeds Stamp & File Number

	A	B	C	D	E	F	G	H	I	J	K	L	M
2	6		5		4		3		2		1		
3													
4	7		8		9		10		11		12		
5													
6	18		17		16		15		14		13		
7													
8	19		20		21		22		23		24		
9													
10	30		29		28		27		26		25		
11													
12	31		32		33		34		35		36		
13													