

SURVEY & REMONUMENTATION

NOV 12 1997

COMMISSION

LAND CORNER RECORDATION CERTIFICATE Filing Requirement of Act 74, Mich. P.A. 1970

For corners in

Gogebic

(County)

Located In:

Corner Code #

Section 26 45N 43W J-11

1. Public Land Survey

T	R	
T	R	
T	R	
T	R	
S	T	R
S	T	R
S	T	R
S	T	R

2. Property Controlling in Section

3. Miscellaneous Property in Sec.

4. Lot No. _____, Recorded Plat _____

5. Private Claims _____

1/4 corner to 26 and 35, T45N, R43W

I, John R. Garske, in a field survey on June/Aug 19 97 hereby state that under requirements of P.A. 74, Michigan P.A. of 1970, the corner points mentioned in lines 1 and 2 above were in conformance with regulations and rules therefore as required in the current manual of survey instructions of the United States Department of the Interior, Bureau of Land Management or by a decree of a Court of Law and/or that the corner points mentioned in lines 3, 4 and 5 above were in conformance with the rules of the Michigan Board of Land Surveyors or by a Decree of a Court of Law; established, re-established, monumented, recovered, found as expressed below:

NOTE: Not more than 2 corners, all in the same town and range, may be recorded on this certificate.

A. Description of original monument and accessories and/or subsequent restoration:

Original survey by Algernon Merryweather, D.S. in 1852
Original BT's:
Sugar 10" S37°E 4 links
Maple 6" N50°W 25 links
13 chains west decend bank

1935 - U.S.F.S. form 87-4 formss indicate a wooden post @ the 1/4 corner location.

B. Description of corner evidence found and/or method applied in restoring or reestablishing corner:

I found a wood post at the corner probably set in 1935, at the East 1/16th corner I also found a wood post very similar in age, the 1/16 post was scribed "1/8" measuring 1314'± East, the distance from the 1/4 post checks at 2628.90' west to the S.W. corner (monumented) indicating the post was probably set at a split. I could find no other evidence of this corner and accepted the post.

PEER GROUP APPROVED

Richard P. Dralun 10/7/97
COUNTY REPRESENTATIVE

(Research on file)


C. Description of monument for corner and accessories established to perpetuate locating the position of the corner:

I set a 2 1/2" x 36" alum. monument with a 3 1/4" dia. alum. cap stamped to identify the corner from which I established:

Maple 7"	N46°E	23.81 feet
Maple 4"	N79°E	20.18 feet
Maple 4"	S40°W	12.23 feet
Maple 5"	N26°W	25.29 feet
Steel sign rail	North	0.93 feet

Signed by John R. Garske
Surveyor's Michigan License No. 28410

Date 10/7/97

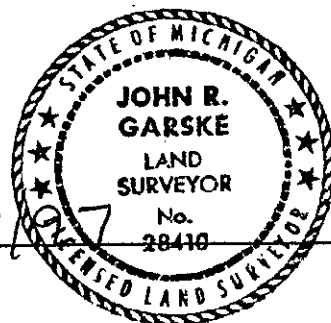

Register's Office } ss.
Gogebic County }

Received for record the
9th day of OCTOBER
A. D. 1997 at 11:00 o'clock
A m., and recorded in
Lib. C of CORNERS

on page 229
Ramona Collins, Deputy
Register of Deeds

Register of Deeds Stamp & File Number

	A	B	C	D	E	F	G	H	I	J	K	L	M
1													
2	6			5			4			3		2	1
3													
4	7			8			9			10		11	12
5													
6	18			17			16			15		14	13
7													
8	19			20			21			22		23	24
9													
10	30			29			28			27		26	25
11													
12	31			32			33			34		35	36
13													