

SURVEY &
REMONUMENTATION

OCT 03 1996

COMMISSION

LAND CORNER RECORDATION CERTIFICATE
Filing Requirement of Act 74, Mich. P.A. 1970

Register's Office }
Gogebic County } ss.

For corners in Gogebic
(County)

Located in:

Corner Code #

1. Public Land Survey T 45N R 43W
T R
T R
T R
2. Property Controlling S T R
in Section S T R
3. Miscellaneous S T R
Property in Section S T R

A-B-3

002

4. Lot No. , Recorded Plat
5. Private Claims

Meander corner common to Sec. 6 & 7, T45N, R43W

I, John R. Garske, in a field survey on October 11, 19 95,
do hereby certify that under requirements of P.A. 74, Michigan P.A. of 1970, the corner points mentioned
in lines 1 and 2 above were in conformance with regulations and rules therefore as required in the current
manual of survey instructions of the United States Department of the Interior, Bureau of Land
Management or by a decree of a Court of Law and/or that the corner points mentioned in lines 3, 4 and
5 above were in conformance with the rules of the Michigan Board of Professional Surveyors or by a
Decree of a Court of Law; established, re-established, monumented, re-monumented, recovered, found
as expressed below:

NOTE: Not more than 4 corners, all in the same town and range, may be recorded
on this certificate.

A. Description of original monument and accessories and/or subsequent restoration:

- Corner established by A. Merryweather, U.S. Deputy Surveyor, in 1852. Original meander corner - 6" cedar. Original bearing tree - 18" hemlock - N80°E, 23 links.
- On June 17, 1966, Donald D. Lappala, L.S. 12585, found a 4" blazed cedar marking the corner position. Lappala set a 2" I.D. x 5' concrete filled galvanized iron pipe capped with a 3" circular bronze tablet which reads: T45N, R43W; M.C., S-6, S-7, RLS 12585, 1966, from which he established the following bearing trees:

5" hemlock - N66°E - 21.9 feet
5" Y. birch - S50°E - 11.4 feet
11" hemlock - S20°W - 38.8 feet

B. Description of corner evidence found and/or method applied in restoring or reestablishing corner:

On October 11, 1994, I found the corner as set by USFS Surveyor, Donald D. Lappala, and recorded in Liber 1, P. 79, 80 as described above.

Act 74 research on file with County Representative.


C. Description of monument for corner and accessories established to perpetuate locating the position of the corner:

I used the 2" iron pipe as set by Lappala and updated the corner to state and county specifications as follows:

8" hemlock - N66°E - 21.81 feet (existing)
8" yellow birch - S50°E - 11.24 feet (existing)
15" hemlock - S20°W - 38.68 feet (existing)
6" steel rail with sign - S13°E - 6.56 feet

PEER GROUP APPROVED

Richard L. Drake 12/14/95
COUNTY REPRESENTATIVE

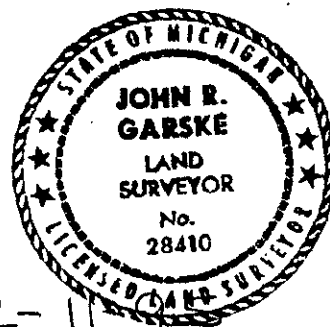

Signed by John R. Garske

Date 12-11-95

Surveyor's Michigan License No. 28410

FORM APPROVED BY MICHIGAN STATE BOARD OF PROFESSIONAL SURVEYORS, JAN. 28, 1971
REVISED MAY 14, 1975
REVISED JAN., 1983