

LAND CORNER RECORDATION CERTIFICATE  
Filing Requirement of Act 74, Mich. P.A. 1970

For corners in

Gogebic  
(County)

Located In:

Corner Code #

1. Public Land Survey

T 45N R 43W A-4  
T 45N R 44W M-4

2. Property Controlling  
in Section

S T R

3. Miscellaneous  
Property in Sec.

S T R

4. Lot No. , Recorded Plat

5. Private Claims

One-quarter corner common to Section 7, T45N, R43W and  
Section 12, T45N, R44W.

I, John R. Garske, in a field survey on January 3, 1995,

do hereby certify that under requirements of P.A. 74, Michigan P.A. of 1970, the corner points mentioned in lines 1 and 2 above were in conformance with regulations and rules therefore as required in the current manual of survey instructions of the United States Department of the Interior, Bureau of Land Management or by a decree of a Court of Law and/or that the corner points mentioned in lines 3, 4 and 5 above were in conformance with the rules of the Michigan Board of Land Surveyors or by a Decree of a Court of Law, established, re-established, monumented, re-monumented, recovered, found as expressed below:

**NOTE: Not more than 4 corners, all in the same town and range, may be recorded on this certificate.**

A. Description of original monument and accessories and/or subsequent restoration:

Original survey by John Burt in 1847. Set cedar post from which a 34" hemlock bears N41°E, 42 links and a 13" hemlock - N62°W, 32 links.

B. Description of corner evidence found and/or method applied in restoring or reestablishing corner:

No original evidence could be found due to logging activity. This corner position was re-established on line between the section corner common to Sections 7, 12 and 13 and the meander corner common to Sections 7 and 12 at a proportionate distance in accordance to the original general land office survey notes.

Record research on file with the Register of Deeds Office.

See sketch on back.


PEER GROUP

Approved

Richard P. Dredman 1/25/95

C. Description of monument for corner and accessories established to perpetuate locating the position of the corner:

Set a 2 1/2" x 30" aluminum monument with a 3 1/4" aluminum cap stamped: T45N, R44W, R43W; S-12; S-7; 1/4; 1995; RLS 28410. I established the following bearing trees and reference objects: 14" sugar - N64°E, 51.80 feet; 8" sugar - S05°E, 51.99 feet; 14" R. Pine - N84°W, 21.61 feet; 6" steel rail with sign - N17°W, 1.32 feet.

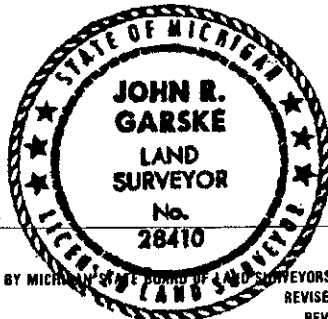

Signed by John R. Garske

Date 1-17-95

Surveyor's Michigan License No. 28410

NO SCALE  
 SKETCH

