

SURVEY & REMONUMENTATION

AUG 08 1997

COMMISSION

LAND CORNER RECORDATION CERTIFICATE Filing Requirement of Act 74, Mich. P.A. 1970

Register's Office }
Gogebic County } ss.

For corners in

Gogebic
(County)

Located In:

Corner Code #

- | | | |
|-------------------------|-------------|-----|
| 1. Public Land Survey | T 45N R 45W | C-4 |
| | T R | |
| | T R | |
| | T R | |
| 2. Property Controlling | S T R | |
| in Section | S T R | |
| 3. Miscellaneous | S T R | |
| Property in Sec. | S T R | |

Received for record the
11TH day of JUNE
A. D. 1997 at 10:45 o'clock
A m., and recorded in
Lib. 6 of CORNERS

on page 146
Colleen M. Richak, Deputy
Register of Deeds

Register of Deeds Stamp & File Number

4. Lot No. _____, Recorded Plat _____
5. Private Claims _____

$\frac{1}{4}$ Corner 7 & 8; T.45 N. R.45 W.

Richard L. Drahn, in a field survey on May 17, 19 97,
do hereby certify that under requirements of P.A. 74, Michigan P.A. of 1970, the corner points mentioned
in lines 1 and 2 above were in conformance with regulations and rules therefore as required in the
current manual of survey instructions of the United States Department of the Interior, Bureau of Land
Management or by a decree of a Court of Law and/or that the corner points mentioned in lines 3, 4 and 5
above were in conformance with the rules of the Michigan Board of Land Surveyors or by a Decree of a
Court of Law; established, re-established, monumented, re-monumented, recovered, found as
expressed below:

**NOTE: Not more than 4 corners, all in the same town and range, may be recorded
on this certificate.**

A. Description of original monument and accessories and/or subsequent restoration:

Corner established by Austin Burt August 9, 1851. Original B.T.s --- 14"
Spruce S.71 W. 54 links (35.64') --- 8" Y. Birch N72 E. 25 links (16.50')---

William Stuth, Wisc. Surveyor set a post at this location from a 1984 traverse
survey of the section line between sec's. 7 & 8.

B. Description of corner evidence found and/or method applied in restoring or reestablishing corner:

Restored corner position at record bearing and distance from the remains of
the two original B.T.s. The first is a vary badly decayed large spruce
root mass. The second one is now a shallow, windthrown stump hole with
pieces of Yellow Birch bark. The 1.00 chain distance south to swamp edge
and the 21.16 chain distance south to GLO Closing Corner on the State Line
are in accordance with the field notes of the Original Government Survey.

Recovered Bill Stuth's 2" downed, squared picket East 6.1 ft. A 12" Cedar
squared for the corner bears S.69 E. 5.2'.


Research form on file with Gogebic County records. Richard L. Drahn 6/10/97

PEER GROUP APPROVED
COUNTY REPRESENTATIVE

C. Description of monument for corner and accessories established to perpetuate locating the position of the corner:

At the corner position I set a 3/4" by 4' long solid aluminum marsh rod
with a 3 1/4" aluminum cap stamped to indicate the corners position, and
the following new scribed B.T.s:

| | | | |
|-----|-----------------|---------|--------|
| 10" | Cedar | N.49 E. | 28.42' |
| 16" | Cedar | S.70 W. | 45.16' |
| 10" | White Spruce | S.27 W. | 38.92' |
| 6' | Steel sign rail | N.50 W. | 1.92' |

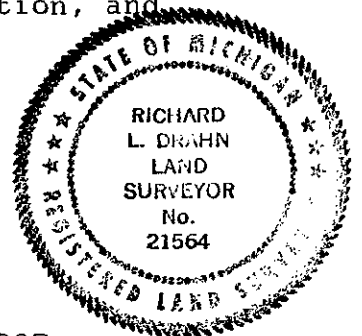

Signed by Richard L. Drahn Date May 19, 1997

Surveyor's Michigan License No. 21564