

LAND CORNER RECORDATION CERTIFICATE Filing Requirement of Act 74, Mich. P.A. 1970

For corners in

Gogebic

(County)

Located in:

Corner Code #

1. Public Land Survey

T46NR 44W

K-4

T___R___

T___R___

T___R___

T___R___

SURVEY &

MEMORUMENTATION

2. Property Controlling
in Section

S___

T___R___

S___

T___R___

3. Miscellaneous
Property in Sec.

S___

T___R___

S___

T___R___

JAN 05 2001

SECTION

Register's Office
Gogebic County

Received for record the

26th day of MAY

A. D. 19⁰⁰ at 11:10 o'clock

A m., and recorded in

Liber 7 of CORNERS

page 324

Cheryl Ruspe
Dep. Register of Deeds

Register of Deeds Stamp & File Number

4. Lot No. _____, Recorded Plat _____

5. Private Claims _____

Quarter corner, Sections 11 & 12, T.46 N., R.44 W.

I, John P. Goss, in a field survey on March 8, 2000 do hereby state that under requirements of P.A. 74, Michigan P.A. of 1970, the corner points mentioned in lines 1 and 2 above were in conformance with regulations and rules therefore as required in the current manual of survey instructions of the United States Department of the Interior, Bureau of Land Management or by a decree of a Court of Law and/or that the corner points mentioned in lines 3, 4 and 5 above were in conformance with the rules of the Michigan Board of Land Surveyors or by a Decree of a Court of Law; established, re-established, monumented, recovered, found as expressed below:

NOTE: Not more than 2 corners, all in the same town and range, may be recorded on this certificate.

	A	B	C	D	E	F	G	H	I	J	K	L
1												
2	6		5		4		3		2		1	
3												
4	7		8		9		10		11		12	
5												
6	18		17		16		15		14		13	
7												
8	19		20		21		22		23		24	
9												
10	30		29		28		27		26		25	
11												
12	31		32		33		34		35		36	
13												

A. Description of original monument and accessories and/or subsequent restoration:

Corner established by Austin Burt, on August 20, 1851.

Original bearing trees: Elm 18" S 31° E 20 links (13.20')

Maple 8" S 54° W 7 links (4.62')

Richard L. Drahn, 21564, on October 26, 1982, re-established corner position by single proportionate method between section corners $\frac{1}{2}$ mile north and south. He set a 2" aluminum pipe with $3\frac{1}{4}$ " aluminum cap, stamped to indicated the corner position. He established the following reference objects: 6" Aspen - N 47° W 19.31 ft.; 11" Balsam - S 89° E - 29.52 ft.; 15" Aspen - S 42° E - 34.90 ft.; 6' metal sign post - N 71° E - 1.3 ft.

B. Description of corner evidence found and/or method applied in restoring or reestablishing corner:

He recorded said corner in Liber 2, page 398 of Land Corners, on 3-15-83.

Found Richard L. Drahn, monument and accessories.

Act 74 research on file.


WILL GROUP APPROVED
Richard L. Drahn 05/24/00
COUNTY REGISTER

C. Description of monument for corner and accessories established to perpetuate locating the position of the corner:

From found monument, stamped to read: T46N- R44W.; 1/4; S-11, S-12; 1982; R.L.S. 21564, I established the following new and existing reference objects:

13" Aspen	N 47° W	19.24 ft.	new nail
16" Balsam	S 89° E	29.52 ft.	
22" Aspen	S 42° E	35.01 ft.	new nail
5" Balsam	S 69° W	29.69 ft.	
6' metal sign post	N 71° E	1.3 ft.	to face

(All measurement taken to nail in side of tree)

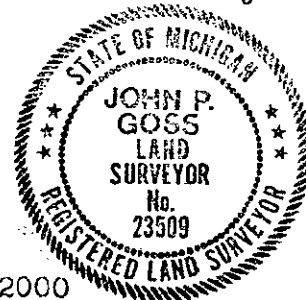

Signed by *John P. Goss*

Date March 8, 2000

Surveyor's Michigan License No. 23509

USFS #G-21