

NOV 12 1997

COMMISSION

LAND CORNER RECORDATION CERTIFICATE
Filing Requirement of Act 74, Mich. P.A. 1970

For corners in

Gogebic
(County)

Located In:

Corner Code ##

1. Public Land Survey

T46N R 46W

AB 12-13

T R

T R

T R

T R

2. Property Controlling
in Section

S T R

S T R

3. Miscellaneous
Property in Sec.

S T R

S T R

002

Register's Office
Gogebic County ss.

Received for record the
9th day of OCTOBER
A. D. 1997 at 10:50 o'clock

A m., and recorded in
Liber 6 of CORNERS

on page 228

Ramona Collins Deputy
Register of Deeds

Register of Deeds Stamp & File Number

4. Lot No. , Recorded Plat

5. Private Claims

Mile Corner No. 1/2, Mich. -- Wisc. State Line

I, Richard L. Drahn in a field survey on September 30, 19 97,
do hereby certify that under requirements of P.A. 74, Michigan P.A. of 1970, the corner points mentioned
in lines 1 and 2 above were in conformance with regulations and rules therefore as required in the
current manual of survey instructions of the United States Department of the Interior, Bureau of Land
Management or by a decree of a Court of Law and/or that the corner points mentioned in lines 3, 4 and 5
above were in conformance with the rules of the Michigan Board of Land Surveyors or by a Decree of a
Court of Law; established, re-established, monumented, re-monumented, recovered, found as
expressed below:

NOTE: Not more than 4 corners, all in the same town and range, may be recorded
on this certificate.

A. Description of original monument and accessories and/or subsequent restoration:

Corner established by William Burt in 1847. Original B.T.s --- Y. Birch 14"
N.03 W. 22 links (14.52') --- Cedar 10" S.26 E. 7 links (4.62') ---

Corner restored By Earl Harrington in 1928 from the remains of the two
original B.T.s. The Cedar B.T. was recovered at S.26 W. He set a standard
brass capped concrete monument and two new B.T.s. --- Spruce 12" N.64-40 E.
22.1' --- Hemlock 14" S.37 W. 25.7'.

Daniel K. Pleoger (Wisc. No. S-1537) recovered the concrete monument and
the remains of the 1928 B.T.s. He established the following new B.T.s:

B. Description of corner evidence found and/or method applied in restoring or reestablishing corner:

--- 5" (6") Yellow Birch N.60 W. (N.59 W.) 35.73' (35.92') --- 13" (12")
Yellow Birch N.46 E. (N.48 E.) 38.30' (38.47') --- 8" (8") Balsam N.65 E.
(N.65 E.) 15.88' (15.82') --- 6" (7") Yellow Birch S.35 W. (S.38 W.)
5.60' (5.64') ---

I recovered the 1928 standard brass capped concrete monument and the
decayed stumps of the two 1928 B.T.s. The Hemlock stump, still scribed
was recovered at S.37 E. rather than at S.37 W. I recovered D.K. Pleogers
B.T.s as described in parentheses above.

No evidence remains of the 1847 B.T.s.

Research form on file with Gogebic County records.


C. Description of monument for corner and accessories established to perpetuate locating the position of the corner:

From the above described concrete monument I established the following:

6' Steel sign rail N.25 E. 2.37'

PEER GROUP APPROVED

Richard L. Drahn 10/8/97
COUNTY REPRESENTATIVE

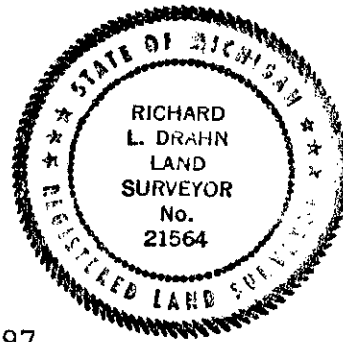

Signed by Richard L. Drahn

Date October 6, 1997

Surveyor's Michigan License No. 21564