

DEC 15 1998

SECTION

LAND CORNER RECORDATION CERTIFICATE  
Filing Requirement of Act 74, Mich. P.A. 1970

Register's Office } ss.  
Gogebic County }

For corners in

GOGEBIC  
(County)

Located In:

Corner Code #

1. Public Land Survey

SECTION 36

T 46 R 47 M-12/13 003  
T 46 R 46 A-12/13 003

2. Property Controlling  
in Section

S      T      R     

3. Miscellaneous  
Property in Sec.

S      T      R     

Received for record the  
30<sup>th</sup> day of OCTOBER  
A. D. 1998 at 9:05 o'clock  
19 m., and recorded in  
Liber 7 of CORNERS  
on page 71  
Ramona Collins Deputy  
Register of Deeds

Register of Deeds Stamp & File Number

4. Lot No.     , Recorded Plat     

5. Private Claims     

CLOSING CORNER ON MI/WI STATE LINE  
SECTIONS 36 & 31, T46N,R46-47W

JOHN R GARSKE OCT. 21, 98

I, JOHN R GARSKE, in a field survey on OCT. 21, 1998 do hereby state that under requirements of P.A. 74, Michigan P.A. of 1970, the corner points mentioned in lines 1 and 2 above were in conformance with regulations and rules therefore as required in the current manual of survey instructions of the United States Department of the Interior, Bureau of Land Management or by a decree of a Court of Law and /or that the corner points mentioned in lines 3, 4 and 5 above were in conformance with the rules of the Michigan Board of Land Surveyors or by a Decree of a Court of Law; established, re-established, monumented, recovered, found as expressed below:

NOTE: Not more than 2 corners, all in the same town and range, may be recorded on this certificate.

|    | A  | B  | C  | D  | E  | F  | G | H | I | J | K | L | M |
|----|----|----|----|----|----|----|---|---|---|---|---|---|---|
| 1  |    |    |    |    |    |    |   |   |   |   |   |   |   |
| 2  | 6  | 5  | 4  | 3  | 2  | 1  |   |   |   |   |   |   |   |
| 3  |    |    |    |    |    |    |   |   |   |   |   |   |   |
| 4  | 7  | 8  | 9  | 10 | 11 | 12 |   |   |   |   |   |   |   |
| 5  |    |    |    |    |    |    |   |   |   |   |   |   |   |
| 6  | 18 | 17 | 16 | 15 | 14 | 13 |   |   |   |   |   |   |   |
| 7  |    |    |    |    |    |    |   |   |   |   |   |   |   |
| 8  | 19 | 20 | 21 | 22 | 23 | 24 |   |   |   |   |   |   |   |
| 9  |    |    |    |    |    |    |   |   |   |   |   |   |   |
| 10 | 30 | 29 | 28 | 27 | 26 | 25 |   |   |   |   |   |   |   |
| 11 |    |    |    |    |    |    |   |   |   |   |   |   |   |
| 12 | 31 | 32 | 33 | 34 | 35 | 36 |   |   |   |   |   |   |   |

A. Description of original monument and accessories and/or subsequent restoration:

ORIGINAL TOWNSHIP SURVEY BY WILLIAM BURT, D.S. IN SEPT. 1847.  
ORIGINAL CORNER: SPRUCE POST  
ORIGINAL BEARING TREES:  
Y.BIRCH 18" N17°W 20 LINKS  
DO 12" N78°E 24 LINKS  
1928-RESURVEY OF STATE LINE BY HARRINGTON, D.S.

B. Description of corner evidence found and/or method applied in restoring or reestablishing corner:

I ESTABLISHED THE CLOSING CORNER BY SINGLE PROPORTIONAL MEASUREMENT ON THE MICHIGAN/ WISCONSIN STATE LINE BETWEEN MILE POST "0" ON THE EAST BANK OF THE MONTREAL RIVER AND MILE POST "1/2". DISTANCES BETWEEN BURT'S, HARRINGTON'S AND OUR SURVEY ARE SHOWN ON THE SKETCH ON THE BACK. A THOROUGH SEARCH OF THE AREA WAS MADE PRIOR TO MONUMENTING WITH NOTHING FOUND.

(RESEARCH ON FILE)


PEER GROUP APPROVED  
Richard R. Dehn 10/27/98  
COUNTY REGISTER


C. Description of monument for corner and accessories established to perpetuate locating the position of the corner:

I SET A 2 1/2" X 30" ALUMINUM PIPE MONUMENT WITH A 3 1/4" DIA. ALUMINUM CAP STAMPED TO IDENTIFY THE CORNER FORM WHICH;  
10" SUGAR MAPLE N22°E 13.59 FEET  
7" SUGAR MAPLE S44°W 10.81 FEET  
10" SUGAR MAPLE N78°W 11.44 FEET  
STEEL SIGN RAIL S45°E 1.50 FEET

Signed by John R Garske  
Surveyor's Michigan License No. 28410

Date 10-26-98

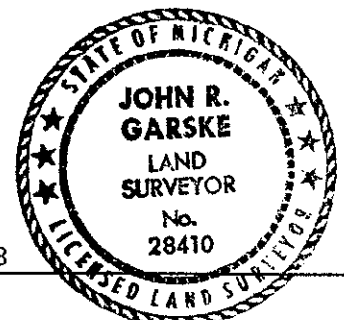

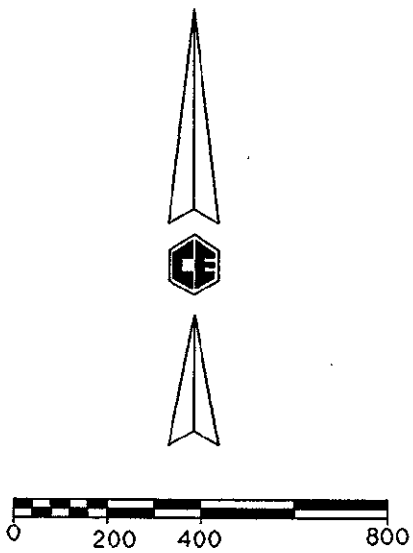

SURVEY &  
REMONUMENTATION

DEC 15 1998

SECTION

UNDERWOOD  
GRADE

25 30  
36 31

MONUMENTED  
RECORDED  
CORNER

R 47 W

R 46 W

RANGE LINE

N 00° 33' 06" E  
2630.04' (M)  
2640.00' (R-GLO)

1/4 COR.  
36 31  
ESTABLISHED  
BY SINGLE  
PROPORTION

N 00° 33' 06" E  
1578.02' (M)  
1584.00' (R-GLO)

MONTREAL  
RIVER

MILE  
MARKER  
NO. 0

FOUND.  
CONC. MON'T.  
(REC.)

APPROX.  
LOCATION

MICHIGAN

WISCONSIN

S 74° 29' 49" E 1522.62' (R-BURT) (23.07 CH.)  
1523.19' (M)

CLOSING  
CORNER  
ESTABLISHED ON  
STATE LINE BY  
SINGLE PROPORTION

S 74° 29' 49" E 2652.84' (M)  
S 74° 27' E (R) 2640' (R-BURT-1847)  
2651.9' (HARRINGTON-1928)

MICHIGAN

STATE LINE

WISCONSIN

MILE  
MARKER  
NO. 1/2

FOUND.  
CONC. MON'T.  
(REC.)