

SURVEY & REMONUMENTATION

JAN 05 2001

SECTION

LAND CORNER RECORDATION CERTIFICATE Filing Requirement of Act 74, Mich. P.A. 1970

Register's Office
Gogebic County

For corners in

Gogebic
(County)

Located in:

Corner Code #

1. Public Land Survey

T46NR47W

I-2

T R

T R

T R

2. Property Controlling S
in Section S

T R

T R

3. Miscellaneous S
Property in Sec. S

T R

T R

4. Lot No. , Recorded Plat

5. Private Claims

Quarter Corner common to Sections 2 and 3.

I, John R. Garske, in a field survey on April 27, 2000, do hereby state that under requirements of P.A. 74, Michigan P.A. of 1970, the corner points mentioned in lines 1 and 2 above were in conformance with regulations and rules therefore as required in the current manual of survey instructions of the United States Department of the Interior, Bureau of Land Management or by a decree of a Court of Law and / or that the corner points mentioned in lines 3, 4, and 5 above were in conformance with the rules of the Michigan Board of Land Surveyors or by a Decree of a Court of Law; established, re-established, monumented, recovered, found as expressed below.

NOTE: Not more than 2 corners, all in the same town and range, may be recorded on this certificate.

Received for record the
2ND day of JUNE
A. D. 1900 at 10:20 o'clock
A. M., and recorded in
Book 7 of CORNERS
Page 350
Cheryl Ruppe, Dep.
Register of Deeds

Register of Deeds Stamp & File
Number

	A	B	C	D	E	F	G	H	I	J	K	L	M
1													
2	5			5		4			3		2		1
3													
4	7		8		9				10		11		12
5													
6	18		17		16		15		14		13		
7													
8	19		20		21		22		23		24		
9													
10	30		29		28		27		26		25		
11													
12	31		32		33		34		35		36		
13													

A. Description of original monument and accessories and / or subsequent restoration:

Original survey by William Ives in 1848.

Original Corner: Wood post

Original Bearing Trees: 18" Hemlock

N 50° E

22 Links

24" Hemlock

S 30° W

25 Links

B. Description of corner evidence found and / or method applied in restoring or re-establishing corner:

I found an ancient fenceline and rock wall running North and South of the point established to be the quarter corner. This was determined from the G.L.O. distance from the section corner North. I found a random fenceline running East from a point approximately 90 feet North of the quarter corner.

I established the ¼ corner on the ancient fence line at the record GLO distance between the section corner and meander corner.

Record research on file.

(see sketch on back)

C. Description of monument for corner and accessories established to perpetuate locating the position of the corner:

I set a 3" x 30" aluminum Bernsten monument at the quarter corner position, from which I established the following witnesses:

4' Steel Sign Rail

S 60° E

2.90 Feet

6" Maple

S 17° W

14.65 Feet

8" Maple

N 63° W

5.14 Feet

4" Balsam

S 63° E


12.48 Feet

Signed by

Surveyor's Michigan License No. 28410

FB # 251, page 21

Date

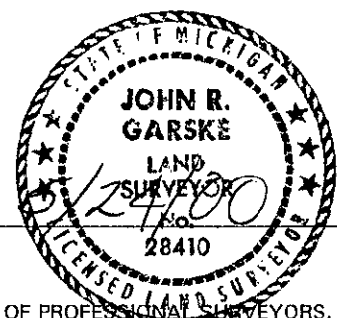

Quarter Corner common to Sections 2 & 3,
T 46 N, R 47 W.

I-2

SURVEY &
REMONUMENTATION

JAN 05 2001

SECTION



Scale: 1" = 400'

