

DEC 15 1998

SECTION

LAND CORNER RECORDATION CERTIFICATE
Filing Requirement of Act 74, Mich. P.A. 1970

For corners in

GOGEBIC
(County)

Located In:

Corner Code #

1. Public Land Survey

SECTION 36

T	R	
T46N	R 47W	M-12
T46N	R 46W	A-12
T	R	
S	T	R
S	T	R
S	T	R
S	T	R

2. Property Controlling
in Section

3. Miscellaneous
Property in Sec.

4. Lot No. _____, Recorded Plat _____

5. Private Claims _____

1/4 CORNER SECTIONS 36 & 31, T46N, R46-47W

I, JOHN R GARSKE, in a field survey on OCT. 21, 1998 do hereby state that under requirements of P.A. 74, Michigan P.A. of 1970, the corner points mentioned in lines 1 and 2 above were in conformance with regulations and rules therefore as required in the current manual of survey instructions of the United States Department of the Interior, Bureau of Land Management or by a decree of a Court of Law and/or that the corner points mentioned in lines 3, 4 and 5 above were in conformance with the rules of the Michigan Board of Land Surveyors or by a Decree of a Court of Law; established, re-established, monumented, recovered, found as expressed below:

NOTE: Not more than 2 corners, all in the same town and range, may be recorded on this certificate.

Register's Office
Gogebic County ss.

Received for record the
30th day of OCTOBER
A. D. 1998 at 9:05 o'clock
A M., and recorded in
Lib. 7 of CORNERS
on page 70
Ramona Collins, Deputy
Register of Deeds

Register of Deeds Stamp & File Number

	A	B	C	D	E	F	G	H	I	J	K	L	M
1													
2	6		5		4		3		2		1		
3													
4	7		8		9		10		11		12		
5													
6	10		17		16		15		14		13		
7													
8	19		20		21		22		23		24		
9													
10	30		29		28		27		26		25		
11													
12	31		32		33		34		35		36		
13													

A. Description of original monument and accessories and/or subsequent restoration:

ORIGINAL SURVEY BY WILLIAM BURT, D.S. IN SEPT. 1847.
ORIGINAL CORNER: CEDAR POST
ORIGINAL BEARING TREES:
CEDAR 6" N68°W 20 LINKS
DO 14" S17E 35 LINKS

B. Description of corner evidence found and/or method applied in restoring or reestablishing corner:

I MADE A THOROUGH SEARCH OF THE CALCULATED POSITION OF THE CORNER AND FOUND NO EVIDENCE OF IT'S LOCATION. I ESTABLISHED THE CORNER BY SINGLE PROPORTIONAL MEASUREMENT ON THE RANGE LINE BETWEEN THE CLOSING CORNER ON THE STATE LINE AND THE SECTION CORNER TO THE NORTH IN ACCORDANCE WITH THE ORIGINAL GOVERNMENT NOTES.

(RESEARCH ON FILE)

(SEE SKETCH ON BACK)


C. Description of monument for corner and accessories established to perpetuate locating the position of the corner:

I SET A 2 1/4" DIA. BY 30" LONG ALUMINUM PIPE MONUMENT WITH A 3 1/4" ALUMINUM CAP, STAMPED TO IDENTIFY THE CORNER, FROM WHICH I ESTABLISHED:


4" SUGAR MAPLE	N21°W	18.50 FEET
6" SUGAR MAPLE	S20°W	18.50 FEET
6" SUGAR MAPLE	N72°W	4.18 FEET
STEEL SIGN RAIL	S45°E	1.55 FEET

Signed by John R Garske
Surveyor's Michigan License No. 28410

Date 10-26-98

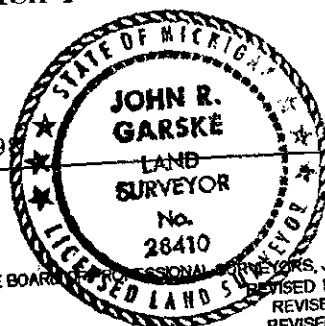

FORM APPROVED BY MICHIGAN STATE BOARD OF LAND SURVEYORS, JAN. 28, 1971
REVISED MAY 14, 1975
REVISED JAN., 1983
REVISED OCT., 1985

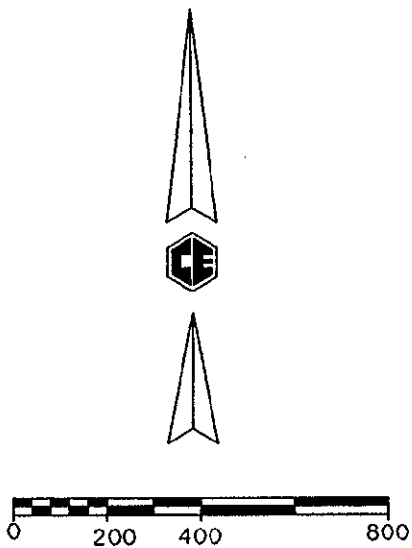

SURVEY &
REMONUMENTATION

DEC 15 1998

SECTION

UNDERWOOD
GRADE

25 30
36 31

MONUMENTED
RECORDED
CORNER

R 47 W

R 46 W

RANGE LINE

N 00° 33' 06" E
2630.04' (M)
2640.00' (R-GLO)

36 31

1/4 COR.
ESTABLISHED
BY SINGLE
PROPORTION

N 00° 33' 06" E
1578.02' (M)
1584.00' (R-GLO)

MONTREAL
RIVER

MILE
MARKER
NO. 0

FOUND.
CONC. MON'T.
(REC.)

APPROX.
LOCATION

MICHIGAN

WISCONSIN

S 74° 29' 49" E 1522.02' (R-BURT) (23.07 CH.)
1523.16' (M)

S 74° 29' 49" E 2652.84' (M)
S 74° 27' E (R) 2640' (R-BURT-1847)
2651.9' (HARRINGTON-1928)

CLOSING
CORNER
ESTABLISHED ON
STATE LINE BY
SINGLE PROPORTION

S 74° 29' 49" E 1129.68' (M)
STATE LINE

MICHIGAN

WISCONSIN

MILE
MARKER
NO. 1/2

FOUND.
CONC. MON'T
(REC.)