

# SURVEY & REMONUMENTATION

JAN 05 2001

## SECTION

## LAND CORNER RECORDATION CERTIFICATE Filing Requirement of Act 74, Mich. P.A. 1970

Register's Office }  
Gogebic County } ss.

For corners in  
Gogebic  
(County)

Located in:

Corner Code #

1. Public Land Survey

T46NR47W

1-2-3

T R

T R

T R

T R

2. Property Controlling S  
in Section S

T R

T R

3. Miscellaneous S  
Property in Sec. S

T R

T R

4. Lot No. \_\_\_\_\_, Recorded Plat \_\_\_\_\_

5. Private Claims \_\_\_\_\_

Meander Corner common to Sections 2 & 3.

Received for record the  
2<sup>ND</sup> day of JUNE  
A. D. 1900 at 10:20 o'clock  
A. m., and recorded in  
Liber 7 of CORNERS  
on page 354  
Cheryl Ruppel, Dep  
Register of Deeds

Register of Deeds Stamp & File  
Number

I, John R. Garske, in a field survey on April 27, 2000, do hereby state that under requirements of P.A. 74, Michigan P.A. of 1970, the corner points mentioned in lines 1 and 2 above were in conformance with regulations and rules therefore as required in the current manual of survey instructions of the United States Department of the Interior, Bureau of Land Management or by a decree of a Court of Law and / or that the corner points mentioned in lines 3, 4, and 5 above were in conformance with the rules of the Michigan Board of Land Surveyors or by a Decree of a Court of Law; established, re-established, monumented, recovered, found as expressed below.

NOTE: Not more than 2 corners, all in the same town and range, may be recorded on this certificate.

	A	B	C	D	E	F	G	H	I	J	K	L	M
1													
2	6		5		4		3		2		1		
3													
4	7		8		9		10		11		12		
5													
6	18		17		16		15		14		13		
7													
8	19		20		21		22		23		24		
9													
10	30		29		28		27		26		25		
11													
12	31		32		33		34		35		36		
13													

### A. Description of original monument and accessories and / or subsequent restoration:

Original survey by William Ives on September 2, 1848.

Original Corner: Wood post

Original Bearing Trees: 18" Fir N 35° E 99 Links  
2" Alder N 65° W 22 Links

DEED GROUP ATTACHED  
Richard L. Drisk 5/24/00  
COUNTY DEPARTMENT & FILE

### B. Description of corner evidence found and / or method applied in restoring or re-establishing corner:

I found no evidence of original corner location but used the rockwall / barbed wire fenceline that ran North and South of the quarter corner to establish alignment and G.L.O. distance to set the meander corner.

Record research on file.  
(see sketch on back)

### C. Description of monument for corner and accessories established to perpetuate locating the position of the corner:


I set a 3" x 30" aluminum Bernsten monument at the determined meander corner location, from which I established the following witnesses:

4' Steel Sign Post S 22° W 1.12 Feet  
12" Maple N 82° W 8.40 Feet  
6" Elm N 10° W 36.93 Feet  
Twin 6" Elm N 81° E 59.22 Feet

Signed by

John R. Garske

Date

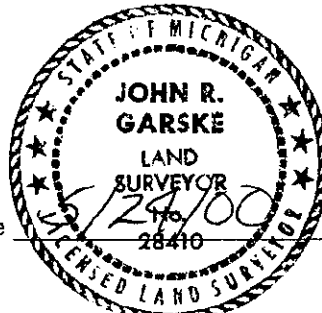

Surveyor's Michigan License No. 28410  
FB # 251, page 23

FORM APPROVED BY MICHIGAN STATE BOARD OF PROFESSIONAL SURVEYORS, JAN. 28, 1971  
REVISED MAY 14, 1975  
REVISED JAN., 1983  
REVISED OCT., 1995

Meander Corner common to Sections 2 & 3,  
T 46 N, R 47 W.

1-2-3

SURVEY &  
REMONUMENTATION

JAN 05 2001

SECTION



Scale: 1" = 400'

