

SURVEY & REMONUMENTATION

JAN 05 2001

SECTION

LAND CORNER RECORDATION CERTIFICATE Filing Requirement of Act 74, Mich. P.A. 1970

For corners in

Gogebic
(County)

Located in:

Corner Code #

1. Public Land Survey

T46NR47W

I-J-3

T R

T R

T R

2. Property Controlling S
in Section S

T R

T R

3. Miscellaneous S
Property in Sec. S

T R

T R

4. Lot No. , Recorded Plat

5. Private Claims

Meander Corner common to Sections 2 and 11.

I, John R. Garske, in a field survey on April 27, 2000, do hereby state that under requirements of P.A. 74, Michigan P.A. of 1970, the corner points mentioned in lines 1 and 2 above were in conformance with regulations and rules therefore as required in the current manual of survey instructions of the United States Department of the Interior, Bureau of Land Management or by a decree of a Court of Law and / or that the corner points mentioned in lines 3, 4, and 5 above were in conformance with the rules of the Michigan Board of Land Surveyors or by a Decree of a Court of Law; established, re-established, monumented, recovered, found as expressed below.

NOTE: Not more than 2 corners, all in the same town and range, may be recorded on this certificate.

Register's Office }
Gogebic County }

Received for record the
2ND day of JUNE
A. D. 19 00 at 10:20 o'clock
A m., and recorded in
Lib. 7 of CORNERS
on page 355
Cheryl Rupp, Dep
Register of Deeds

Register of Deeds Stamp & File
Number

	A	B	C	D	E	F	G	H	I	J	K	L	M
1													
2	6		5		4		3		2		1		
3													
4	7		8		9		10		11		12		
5													
6	18		17		16		15		14		13		
7													
8	19		20		21		22		23		24		
9													
10	30		29		28		27		26		25		
11													
12	31		32		33		34		35		36		
13													

A. Description of original monument and accessories and / or subsequent restoration:

Original survey by William Ives on September 3, 1848.
Original Corner: Wood post

B. Description of corner evidence found and / or method applied in restoring or re-establishing corner:

I found no evidence of the original meander corner. The corner position was determined by an old barbed wire fenceline used to set the quarter corner to the East, and the G.L.O. distance was used to set the original corner.

Record research on file.
(see sketch on back)

PEER GROUP APPROVED
Richard L. Dyer 5/24/00
COUNTY BOARD OF LAND SURVEYORS

C. Description of monument for corner and accessories established to perpetuate locating the position of the corner:


I set a 3" x 30" aluminum Bernstein cap as the witness to the meander corner 29.38 feet East of the original G.L.O. position. I established the following witnesses:

4' Steel Sign Post	N 41° W	2.58 Feet
12" Ash	S 78° E	75.31 Feet
5" Red Maple	N 62° E	75.79 Feet
4" Red Maple	S 21° W	37.42 Feet

Signed by

John R. Garske

Date

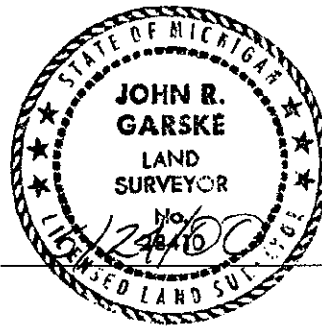

Surveyor's Michigan License No. 28410
FB # 251, page 25

FORM APPROVED BY MICHIGAN STATE BOARD OF PROFESSIONAL SURVEYORS, JAN. 28, 1971
REVISED MAY 14, 1975
REVISED JAN., 1983
REVISED OCT., 1995


Meander Corner common to Sections 2 & 11,
T 46 N, R 47 W.

I J-3

SURVEY &
REMONUMENTATION

JAN 05 2001

SECTION

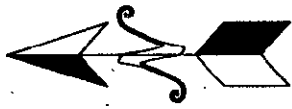

Scale: 1" = 500'

