

SURVEY & REMONUMENTATION

JAN 05 2001

(Official)

SECTION

LAND CORNER RECORDATION CERTIFICATE Filing Requirement of Act 74, Mich. P.A. 1970

Register's Office } ss.
Gogebic County }

For corners in
Gogebic
(County)

Located in:

Corner Code #

1. Public Land Survey

T46NR47W

K-L-7

T R

T R

T R

2. Property Controlling S
in Section S

T R

T R

3. Miscellaneous S
Property in Sec. S

T R

T R

4. Lot No. _____, Recorded Plat _____

5. Private Claims _____

Meander Corner common to Sections 13 and 24.

I, John R. Garske, in a field survey on April 26, 2000, do hereby state that under requirements of P.A. 74, Michigan P.A. of 1970, the corner points mentioned in lines 1 and 2 above were in conformance with regulations and rules therefore as required in the current manual of survey instructions of the United States Department of the Interior, Bureau of Land Management or by a decree of a Court of Law and / or that the corner points mentioned in lines 3, 4, and 5 above were in conformance with the rules of the Michigan Board of Land Surveyors or by a Decree of a Court of Law; established, re-established, monumented, recovered, found as expressed below.

NOTE: Not more than 2 corners, all in the same town and range, may be recorded on this certificate.

Received for record the
2ND day of JUNE
A. D. 19 00 at 10:20 o'clock
A m., and recorded in
Liber 7 of CORNERS
on page 358
Cheryl Rippe, Dep
Register of Deeds

Register of Deeds Stamp & File
Number

	A	B	C	D	E	F	G	H	I	J	K	L	M
1													
2	6			5		4		3		2		1	
3													
4	7			8		9		10		11		12	
5													
6	18			17		16		15		14		13	
7													
8	19			20		21		22		23		24	
9													
10	30			29		28		27		26		25	
11													
12	31			32		33		34		35		36	
13													

A. Description of original monument and accessories and / or subsequent restoration:

Original survey by William Ives in 1848.

Original Corner: Wood post

Original Bearing Trees: 10" Elm S 45° E 87 Links
2" Alder N 60° E 9 Links

B. Description of corner evidence found and / or method applied in restoring or re-establishing corner:

I found an old fenceline extending West from the quarter corner common to 13 and 24. I also found a fenceline running North from the East-West fenceline mentioned above at the approximate location of the West one-sixteenth line. The meander corner was set online with the ancient East-West fenceline and at the G.L.O. Distance.

Record research on File.

(see sketch on back)

DEED GROUP APPROVED
Richard R. Decker 5/24/00
COUNTY DEPARTMENT

C. Description of monument for corner and accessories established to perpetuate locating the position of the corner:


I set a 30" aluminum Bernsten monument to locate the meander corner position, from which I established the following witnesses:

4' Steel Sign Rail S 73° E 1.64 Feet
8" Elm S 42° E 17.78 Feet
12" Black Cherry N 52° E 84.60 Feet
4" Black Cherry S 52° E 50.57 Feet

Signed by

John R. Garske


Date

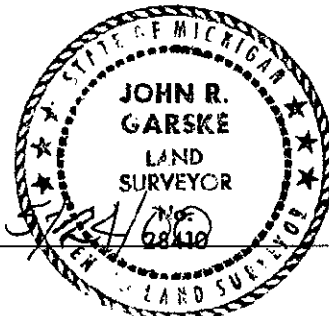

Surveyor's Michigan License No. 28410
FB # 251, page 17 & FB # 213, page 97

Meander Corner common to Sections 13 & 24,
T 46 N, R 47 W.

SURVEY &
REMONUMENTATION
JAN 05 2001
SECTION

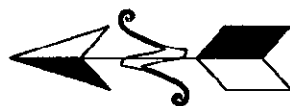

Scale: 1" = 300'

