

SURVEY & REMONUMENTATION

JAN 22 1998

SECTION

LAND CORNER RECORDATION CERTIFICATE Filing Requirement of Act 74, Mich. P.A. 1970

For corners in

Gogebic

(County)

Located In:

Corner Code #

1. Public Land Survey

Section 21 47N 46W E-8

T	R
T	R
T	R
T	R
S	T
S	T
S	T
S	T

2. Property Controlling in Section

3. Miscellaneous Property in Sec.

4. Lot No. _____, Recorded Plat _____
5. Private Claims _____

1/4 corner sections 20 & 21, T47N, R46W

I, John R. Garske, in a field survey on November 3, 1997 do hereby state that under requirements of P.A. 74, Michigan P.A. of 1970, the corner points mentioned in lines 1 and 2 above were in conformance with regulations and rules therefore as required in the current manual of survey instructions of the United States Department of the Interior, Bureau of Land Management or by a decree of a Court of Law and /or that the corner points mentioned in lines 3, 4 and 5 above were in conformance with the rules of the Michigan Board of Land Surveyors or by a Decree of a Court of Law; established, re-established, monumented, recovered, found as expressed below:

NOTE: Not more than 2 corners, all in the same town and range, may be recorded on this certificate.

A. Description of original monument and accessories and/or subsequent restoration:

Original survey by Austin Burt, D.S. in 1851. He set a wood post from which:
Fir - 6" S80°E 3 links
Fir - 6" N76°W 23 links

B. Description of corner evidence found and/or method applied in restoring or reestablishing corner:

I found no evidence of the original corner position or any subsequent surveys, occupation lines or fence lines. I positioned the corner by single proportional measurement, on line and at the mid-point between opposing section corners, in accordance with the original government notes.

(Research on file)


PEER GROUP APPROVED
Richard L. Drab 12/1/97
COURT RECORDED

C. Description of monument for corner and accessories established to perpetuate locating the position of the corner:

I set a 2 1/2" dia. x 30" long alum. pipe with a 3 1/4" dia. alum. cap stamped to identify the corner, from which:
4' Balsam N25°E 10.54 feet
6" Sugar S86°W 9.90 feet
Steel sign rail S60°E 2.53 feet
Steel sign rail S07°W 17.77 feet

Signed by John R. Garske
Surveyor's Michigan License No. 28410

Date 11/28/97

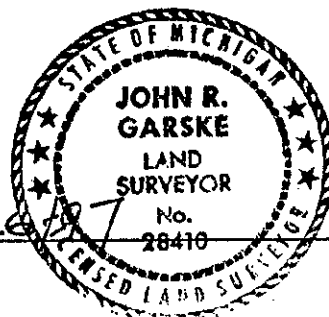

Register's Office } ss.
Gogebic County }

Received for record the
2nd day of December
A. D. 1997 at 10:35 o'clock
A m., and recorded in
Liber 6 of GOGBIC
on page 278
Ramona Collins Deputy
Register of Deeds

Register of Deeds Stamp & File Number

1	A	B	C	D	E	F	G	H	I	J	K	L	M
2		6		5		4		3		2		1	
3													
4		7		8		9		10		11		12	
5													
6		18		17		16		15		14		13	
7													
8		19		20		21		22		23		24	
9													
10		30		29		28		27		26		25	
11													
12		31		32		33		34		35		36	
13													