

**LAND CORNER RECORDATION CERTIFICATE**  
Filing Requirement of Act 74, Mich. P.A. 1970

For corners in

GOGEBIC

(County)

Located in:

Corner Code #

1. Public Land Survey

T48NR 44W

G-7

2. Property Controlling in Section

S

T

**SURVEY & MONUMENTATION**

3. Miscellaneous Property in Sec.

S

T

**JAN 05 2001**

S

T

**SECTION**

4. Lot No. \_\_\_\_\_, Recorded Plat \_\_\_\_\_

5. Private Claims \_\_\_\_\_

Section corner common to sections 17, 18, 19 & 20, T.48 N., R.44 W

I, John P. Goss, in a field survey on Sept 10, 2000 do hereby state that under requirements of P.A. 74, Michigan P.A. of 1970, the corner points mentioned in lines 1 and 2 above were in conformance with regulations and rules therefore as required in the current manual of survey instructions of the United States Department of the Interior, Bureau of Land Management or by a decree of a Court of Law and/or that the corner points mentioned in lines 3, 4 and 5 above were in conformance with the rules of the Michigan Board of Land Surveyors or by a Decree of a Court of Law; established, re-established, monumented, recovered, found as expressed below:

NOTE: Not more than 2 corners, all in the same town and range, may be recorded on this certificate.

Register's Office  
Gogebic County

Received for record the

2<sup>ND</sup> day of OCTOBER

A. D. 19 at 10:50 o'clock

A m., and recorded in

Liber 8 of CORNERS

page 25

Ramona Collins, Deputy  
Register of Deeds

Register of Deeds Stamp & File Number

A	B	C	D	E	F	G	H	I	J	K	L	M
1												
2	6	5	4	3	2	1						
3												
4	7	8	9	10	11	12						
5												
6	18	17	16	15	14	13						
7												
8	19	20	21	22	23	24						
9												
10	30	29	28	27	26	25						
11												
12	31	32	33	34	35	36						
13												

A. Description of original monument and accessories and/or subsequent restoration:  
Corner established by Austin Burt, in 1848.

Original bearing trees: Hemlock 18" S 74° W 8 links (5.28 ft.)  
Black Ash 12" N 74° E 28 links (18.48 ft.)

Donald D. Lappala, 12585, on Sept. 8, 1972, restored corner position at record bearing and distance from the decay stump of the hemlock bearing tree and from the stump hole of the black ash B.T. He set a 2" I.D. iron pipe with 3" bronze tablet, stamped to indicated the corner position. He established the following reference objects:

4" Cedar N 08° W 4.7 ft. 6" Yellow Birch S 25° E 29.4 ft.

B. Description of corner evidence found and/or method applied in restoring or reestablishing corner:  
16" Y. Birch S 77° W 31.6 ft. Metal sign post N 02° W 1.9 ft.

He recorded said corner in U.S.F.S. Liber, Index N-5 on Dec. 9, 1974.

Found a hemlock stump at ground level at S 74° W 8 links.


Found Donald D. Lappala monument and accessories.

Act 74 research on file.

Richard L. Dean 9/27/00  
COUNTY REGISTER

C. Description of monument for corner and accessories established to perpetuate locating the position of the corner:  
From found monument stamped to read: T.48 N., R.44 W.; S-17, S-18, S-19, S-20;  
R.L.S. 12585; 1972, from which I established the following existing and new reference objects:

7" Cedar N 08° W 4.77 ft.  
9" Tw. Yellow Birch S 25° E 30.89 ft.  
18" Yellow Birch S 77° W 31.68 ft.  
8" Ash S 73° E 15.37 ft.  
Metal sign post N 02° W 1.95 ft. to face  
(All measurement taken to nail in side of tree)

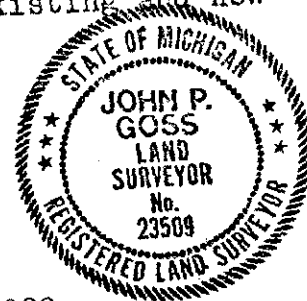

Signed by John P. Goss

23509

Surveyor's Michigan License No.

Date Sept. 11, 2000

U.S.F.S. No. N-5

FORM APPROVED BY MICHIGAN STATE BOARD OF PROFESSIONAL SURVEYORS, JAN. 28, 1971  
REVISED MAY 14, 1975  
REVISED JAN., 1983  
REVISED OCT., 1996