

DEC 15 1998

SECTION

LAND CORNER RECORDATION CERTIFICATE
Filing Requirement of Act 74, Mich. P.A. 1970

For corners in

Gogebic
(County)

Located In:

Corner Code ##

1. Public Land Survey T 48N R 45W D-9
T R
T R
T R
2. Property Controlling S T R
in Section S T R
3. Miscellaneous S T R
Property in Sec. S T R

4. Lot No. , Recorded Plat
5. Private Claims

$\frac{1}{4}$ Corner 20 & 29; T.48 N., R.45 W.

I, Richard L. Drahn in a field survey on August 21, 19 98, do hereby certify that under requirements of P.A. 74, Michigan P.A. of 1970, the corner points mentioned in lines 1 and 2 above were in conformance with regulations and rules therefore as required in the current manual of survey instructions of the United States Department of the Interior, Bureau of Land Management or by a decree of a Court of Law and/or that the corner points mentioned in lines 3, 4 and 5 above were in conformance with the rules of the Michigan Board of Land Surveyors or by a Decree of a Court of Law; established, re-established, monumented, re-monumented, recovered, found as expressed below:

NOTE: Not more than 4 corners, all in the same town and range, may be recorded on this certificate.

A. Description of original monument and accessories and/or subsequent restoration:

Corner established by Austin Burt on 9/27/1848. Original B.T.s --- 10" Hemlock S.18 W. 15 links (9.90') --- 6" Cedar N.12 E. 6 links (3.96') ---

B. Description of corner evidence found and/or method applied in restoring or reestablishing corner:

Restored corner at record bearing and distance from the remains of the two original B.T.s. The first is a 16-24" dead in place Hemlock with Hemlock bark and a downwind line of Hemlock knots. The second one is now a series of root holes (species undetermined). GPS distance west to recovered section corner and east to recovered $\frac{1}{4}$ corner is consistent with the original field notes.

Corner research on file with Gogebic County records.


PEER GROUP APPROVED

Richard L. Drahn 9/16/98
COUNTY ~~REGISTERED~~

C. Description of monument for corner and accessories established to perpetuate locating the position of the corner:

At the corner position I set a 3/4" X 4' long aluminum rod with a 3 1/2" stamped aluminum cap and the following new B.T.s;

6"	Cedar	N.69 W.	14.66'
13"	Hemlock	N.02 E.	27.43'
8"	Hemlock	S.31 E.	14.57'
6'	Steel sign rail	N.87 E.	1.76'

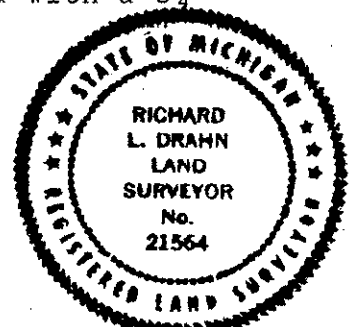

Signed by Richard L. Drahn

Date August 28, 1998

Surveyor's Michigan License No. 21564