

# SURVEY & REMONUMENTATION

JUN 29 1995

COMMISSION

## LAND CORNER RECORDATION CERTIFICATE Filing Requirement of Act 74, Mich. P.A. 1970

Register's Office }  
Gogebic County } ss.

For corners in

	Gogebic (County)	Located In:	Corner Code ##
1. Public Land Survey	S-15	T 48N R 47W	G-7
		T R	
		T R	
		T R	
2. Property Controlling in Section	S T	T R	
	S T	T R	
3. Miscellaneous Property in Sec.	S T	T R	
	S T	T R	

Received for record the  
12<sup>th</sup> day of APRIL  
A.D. 1995 at 1:30 o'clock  
P.M., and recorded in  
Book 5 of CORNERS  
Page 241  
Barbara Collins Deputy  
Register of Deeds

Register of Deeds Stamp & File Number

4. Lot No. \_\_\_\_\_, Recorded Plat \_\_\_\_\_  
5. Private Claims \_\_\_\_\_  
Section corner common to Sections 15, 16, 21 & 22, T48N, R47W

	A	B	C	D	E	F	G	H	I	J	K	L	M
2	6	5	4	3	2	1							
3													
4	7	8	9	10	11	12							
5													
6	18	17	16	15	14	13							
7													
8	19	20	21	22	23	24							
9													
10	30	29	28	27	26	25							
11													
12	31	32	33	34	35	36							
13													

I, John R. Garske, in a field survey on March 31, 19 95,  
do hereby certify that under requirements of P.A. 74, Michigan P.A. of 1970, the corner points mentioned  
in lines 1 and 2 above were in conformance with regulations and rules therefore as required in the  
current manual of survey instructions of the United States Department of the Interior, Bureau of Land  
Management or by a decree of a Court of Law and/or that the corner points mentioned in lines 3, 4 and 5  
above were in conformance with the rules of the Michigan Board of Land Surveyors or by a Decree of a  
Court of Law; established, re-established, monumented, re-monumented, recovered, found as  
expressed below:

**NOTE: Not more than 4 corners, all in the same town and range, may be recorded  
on this certificate.**

### A. Description of original monument and accessories and/or subsequent restoration:

- On September 17, 1848, William Ives set section corner post from which a 14" cedar bears - S70°E, 18 links and a 9" hemlock - N35W, 21 links.
- USDA Form 874-9 dated 3/29/35 - No corner found. States corner location at road intersections. Found 6" maple with tag from which this corner bears S.W. - 66.0 feet.

### B. Description of corner evidence found and/or method applied in restoring or reestablishing corner:

I verified the corner position with measurements from existing corners and is positioned on centerline intersection of a N-S paved road, a gravel road running west and a trail running east.


I found U.S.F.S. tag in 12" B. ash bearing N55°W - 48.28 feet.

Record research on file with Register of Deeds.

PEER GROUP APPROVED  
Richard L. Drab 4/6/95

### C. Description of monument for corner and accessories established to perpetuate location of the corner:

I set a 3 1/4" diameter brass cap stamped: T48N, R47W; S-16; S-15; S-21; S-22; 1995; RLS 28410, from which I established the following bearing trees and reference objects: 6" twin hemlock - S56°E, 50.58 feet; 8" balsam fir - S55°W, 51.16 feet; 12" black ash - N55°W, 48.28 feet; a reference monument consisting of a 2 1/2" diameter x 30" long aluminum pipe with a 3 1/4" aluminum cap stamped: County Remonumentation; T48N, R47W; R.M.; S-15; S-16; S-21; S-22; 1995; RLS 28410; S65°W, 37.48 feet; a 6 foot steel rail with sign - 0.84 feet away.

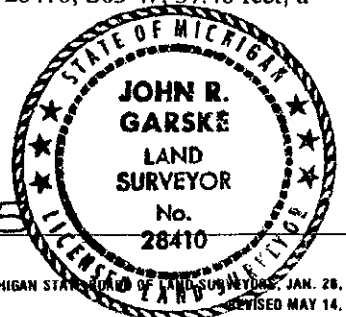

Signed by John R. Garske  
Surveyor's Michigan License No. 28410

Date 4-6-95