

SURVEY & REMONUMENTATION

OCT 0 3 1996

COMMISSION

LAND CORNER RECORDATION CERTIFICATE Filing Requirement of Act 74, Mich. P.A. 1970

Register's Office }
Gogebic County } ss.

For corners in

Gogebic
(County)

Located In:

Corner Code 4

- | | | |
|------------------------------------|---------------------------|------------|
| 1. Public Land Survey | T <u>48N</u> R <u>49W</u> | <u>I-4</u> |
| | T _____ R _____ | _____ |
| | T _____ R _____ | _____ |
| | T _____ R _____ | _____ |
| 2. Property Controlling in Section | S _____ T _____ R _____ | _____ |
| | S _____ T _____ R _____ | _____ |
| 3. Miscellaneous | S _____ T _____ R _____ | _____ |
| Property in Sec. | S _____ T _____ R _____ | _____ |

Received for record the
10th day of JUNE
A. D. 1996 at 9:40 o'clock
A m., and recorded in
Liber 5 of CORNERS
on page 363
Ramona Collins, Deputy
Register of Deeds

Register of Deeds Stamp & File Number

4. Lot No. _____, Recorded Plat _____
5. Private Claims _____
- 1/4 Sec. cor. comm. to sec's 10 & 11

	A	B	C	D	E	F	G	H	I	J	K	L	M
2	6	5	4	3	2	1							
3													
4	7	8	9	10	11	12							
5													
6	18	17	16	15	14	13							
7													
8	19	20	21	22	23	24							
9													
10	30	29	28	27	26	25							
11													
12	31	32	33	34	35	36							
13													

I, John P. Goss, in a field survey on May 13, 1996, do hereby certify that under requirements of P.A. 74, Michigan P.A. of 1970, the corner points mentioned in lines 1 and 2 above were in conformance with regulations and rules therefore as required in the current manual of survey instructions of the United States Department of the Interior, Bureau of Land Management or by a decree of a Court of Law and/or that the corner points mentioned in lines 3, 4 and 5 above were in conformance with the rules of the Michigan Board of Land Surveyors or by a Decree of a Court of Law; established, re-established, monumented, re-monumented, recovered, found as expressed below:

NOTE: Not more than 4 corners, all in the same town and range, may be recorded on this certificate.

A. Description of original monument and accessories and/or subsequent restoration:

Original corner established by William Ives on August 14, 1848. Set post.
Original bearing trees: Y. Birch 14" S 60° W 27 links
Cedar 15" N 53° E 37 links

John Garske in 1981 restored 1/4 corner position at recorded bearing and distance from remains of 2 original bearing trees. He set a 2" galvanized pipe with 2" brass cap. Garske recorded said corner in Liber 2 page 131 of Land Corners for Gogebic County. The following reference objects were established 8" Maple- S 62° E- 22.45'; 6" Maple- S 87° W- 41.72'.

B. Description of corner evidence found and/or method applied in restoring or reestablishing corner:

I found the 2" galvanized pipe with 2" brass cap as noted in John Garske certif. and it checked with John R. Garske certification. I updated the corner monument and accessories as noted below to state and county specification.


Act 74 reseach on file.

PEER GROUP APPROVED
Richard R. Dehn 6/6/96
COUNTY REPRESENTATIVE

C. Description of monument for corner and accessories established to perpetuate locating the position of the corner:

From the monument stated above I established the following bearing trees and reference objects.

8" Maple	S 62° E	22.45'
7" Twin Maple	S 87° W	41.72'
8" W. Birch	N 61° W	31.12'
6' Rail & sign	N 10° W	2.46'
4" Maple	N 24° E	21.20'

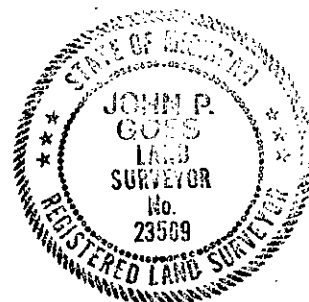

Signed by John P. Goss

Date May 14, 1996

Surveyor's Michigan License No. 23509

Fed. No. G-17

FORM APPROVED BY MICHIGAN STATE BOARD OF LAND SURVEYORS, JAN. 28, 1971
REVISED MAY 14, 1975
REVISED JAN. 1983