

LAND CORNER RECORDATION CERTIFICATE

FILING REQUIREMENT OF ACT 74, MICH. P.A.1970

FOR CORNERS OF--	LOCATED IN--	CORNER CODE NUMBER
1. PUBLIC LAND SURVEY	T. 25 N. R. 10 W.	K-10;
2. PROPERTY CONTROLLING IN SECTION- 26	T. 25 N. R. 10 W.	14
3. MISCELLANEOUS PROPERTY IN SECTION	T. N. S. R. E. W.	
4. LOT NO. , RECORDED PLAT		
5. PRIVATE CLAIMS		

REGISTER OF DEEDS STAMP AND
FILING NUMBER

I, CARL F. ROSER do hereby certify that under requirements of P.A. 74, Michigan P.A. of 1970, the corner points mentioned in lines 1 and 2 above were, in a field survey on SEPTEMBER 26, 1983, established, re-established, monumented, re-monumented, recovered or restored as expressed below and in conformance with regulations and rules therefore as required in the current manual of survey instructions of the United States Department of the Interior, Bureau of Land Management or by a decree of a court of law. Furthermore, that the corner points mentioned in lines 3, 4 and 5 above were, in a field survey on _____, 19____, found, recovered, restored, established or re-established as expressed below and in conformance with the rules of the Michigan State Board of Registration for Land Surveyors or, by a Decree of a Court of law:

A. Description of original monument and accessories and/or subsequent restoration:

B. Description of corner evidence found and/or method applied in restoring or re-establishing corner:

- 14 - FD 1 1/4" PIPE (W/THREADS ON TOP) 5'± E. OF N-S TRAIL & 1' S. OF FN TO WEST. PIPE IS BETWEEN GATE POSTS (GATE POST W/NO TRESS. SIGN, ENE, 3.2'). THIS 1/8 CORNER WAS ESTABLISHED BY COUNTY SURVEYOR, E.P. WATERMAN IN 1907, MID-WAY & ON LINE BETWEEN 1/4 CORNER TO N. & SEC. COR. TO S. AN OLDER N-S FN (CEDAR POSTS-DOWN) WITH NEW N-S FN BUILT (IN-PLACE) IS 16'± EAST.
- K-10 - RECOVERED 1 1/4" IRON (W/STONE OVER IT) AS RECOVERED BY COUNTY SURVEYOR, E.P. WATERMAN IN 1907. CORNER IS IN EAST EDGE OF N-S TRAIL ROAD, IN LINE WITH OLD FENCE TO E & W AND BETWEEN OLD N-S R.O.W. FENCES.

C. Description of monument for corner and accessories established to perpetuate locating the position of the corner:

14			K-10		
FOUND 1 1/4" PIPE			FOUND 6" X 12" STONE OVER 1 1/4" X 12"		
8" RED PINE	S60°W	30.84'	SOLID IRON, REPLACED W/1" X 36" PIPE W/		
9" RED PINE	S14°W	45.37'	RLS CAP.		
3" WHITE PINE	S76°E	15.00'	3" WHITE PINE	S58°W	58.50'
			4" RED PINE	N58°W	34.98'
			4" RED PINE	N60°E	42.80'
			FD 5/8" RE-ROD	N78°18'W	52.72'
			PUT LOC TAG ON	EAST	32.5'±
			OLD CED POST		

SIGNED BY Carl F. Roser 6/6/84

DATE

SURVEYOR'S MICHIGAN REGISTRATION NO. 12028

FOR STATE AND UNITED STATES AGENCIES:

SIGNED BY


DATE

CHIEF OF SURVEY PARTY

APPROVED AND SIGNED BY

MICHIGAN REGISTERED LAND SURVEYOR

DATE

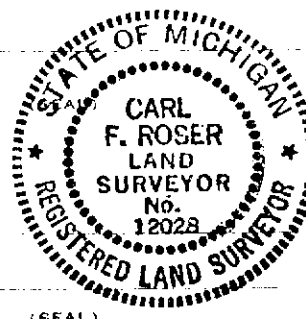

(SEAL)

SURVEYOR'S MICHIGAN REGISTRATION NO. _____

GRAND TRAVERSE COUNTY