

LAND CORNER RECORDATION CERTIFICATE

FILING REQUIREMENT OF ACT 74, MICH. P.A.1970

FOR CORNERS OF--	LOCATED IN--	CORNER CODE NUMBER
1. PUBLIC LAND SURVEY	T. 25 N. R. 10 W.	I-12
2. PROPERTY CONTROLLING IN SECTION	26 T. 25 N. R. 10 W.	10
3. MISCELLANEOUS PROPERTY IN SECTION	35 T. 25 N. R. 10 W.	3
4. LOT NO.	RECORDED PLAT	
5. PRIVATE CLAIMS		

REGISTER OF DEEDS STAMP AND FILING NUMBER

I, CARL F. ROSER, do hereby certify that under requirements of P.A. 74, Michigan P.A. of 1970, the corner points mentioned in lines 1 and 2 above were, in a field survey on OCTOBER 12, 1985, established, re-established, monumented, re-monumented, recovered or restored as expressed below and in conformance with regulations and rules therefore as required in the current manual of survey instructions of the United States Department of the Interior, Bureau of Land Management or by a decree of a court of law. Furthermore, that the corner points mentioned in lines 3, 4 and 5 above were, in a field survey on _____, 19____, found, recovered, restored, established or re-established as expressed below and in conformance with the rules of the Michigan State Board of Registration for Land Surveyors or, by a Decree of a Court of law:

C. (CONTINUED)

XX

3 - Sec. 35

DROVE 5/8" X 34" REROD W/RLS CAP
 6" CHERRY STUMP N16°E 66.33
 COR FN POST S82°E 20.16
 20" MAPLE S48°E 97.43
 SET CED POST
 W/LOC TAG. EAST 33'
 20" MAPLE S20°E 122.60'

B. Description of corner evidence found and/or method applied in restoring or re-establishing corner:

- I-12 FD & ACCEPTED 1/2" REROD BY R. MITCHELL AS SET MIDWAY AND ON LINE BETW FD NW & SW COR'S OF SEC 35, AS CALLED FOR IN H.F.NORTHROP 1896 SURVEY.
 10-Sec. 26 ESTABLISHED SW COR OF N1/2 OF SW 1/4 OF SEC 26 EQUIDISTANT & ON LINE BETW FD SEC COR TO SOUTH & 1/4 COR TO NORTH.
 3-Sec. 35 ESTAB NW COR OF S 1/2 - NW 1/4 OF SEC 35 MIDWAY & ON LINE BETW SEC COR N. & R.MITCHELL 1/4 COR S. E-W FN TO EAST IS IRREGULAR & BOWS SOUTHERLY. CORNER FALLS IN APPROX CTR OF N-S GRAVEL RD.

C. Description of monument for corner and accessories established to perpetuate locating the position of the corner:

I-12

10 - Sec. 26

FD 1/2" REROD W/RLS CAP #28417	SET 5/8" X 3' REROD W/RLS CAP (BURIED .4')
5" LOCUST S38°W 60.3'	8" R PINE N60°E 99.90
28" ASH N84°E 46.65'	6" SCOTCH PINE S65°E 84.10
14" MAPLE S50°E 47.87'	13" CHERRY (CLUMP) S30°W 116.05
CORNER FN POST FN S & W WEST 28'	SET CEDAR POST EAST 33'
SET CED POST W/LOC TAG. S84°E 28.88'	CTR N-S ROAD EAST 6'±
	OLD COR FN POST HOLE EAST 34'
	(FN N & E DOWN)

SIGNED BY Carl F. Roser 01-17-86 DATE

SURVEYOR'S MICHIGAN REGISTRATION NO. 12028


FOR STATE AND UNITED STATES AGENCIES:

SIGNED BY _____ DATE

CHIEF OF SURVEY PARTY

APPROVED AND SIGNED BY _____ DATE

MICHIGAN REGISTERED LAND SURVEYOR

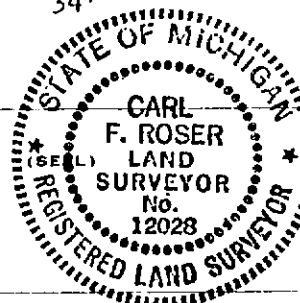

(SEAL)

SURVEYOR'S MICHIGAN REGISTRATION NO. _____

PARADISE TWP
 GD. TRAVERSE COUNTY