

LAND CORNER RECORDATION CERTIFICATE

FILING REQUIREMENT OF ACT 74, MICH. P.A.1970

FOR CORNERS OF--	LOCATED IN--	CORNER CODE NUMBER
1. PUBLIC LAND SURVEY_____	T. 25 N. R. 11 W. ●	L-12; L-13
2. PROPERTY CONTROLLING IN SECTION 36, T. 25 N. R. 11 W. ●		5; 12
3. MISCELLANEOUS PROPERTY IN SECTION_____, T._____, S. R._____, E. W. ●		
4. LOT NO._____, RECORDED PLAT_____		
5. PRIVATE CLAIMS_____		

REGISTER OF DEEDS STAMP AND
FILING NUMBER

I, Carl F. Roser do hereby certify that under requirements of P.A. 74, Michigan P.A. of 1970, the corner points mentioned in lines 1 and 2 above (identified with circles on index code diagram-over) were, in a field survey on May 22, 1974, established, re-established, monumented, re-monumented, recovered or restored as expressed below and in conformance with regulations and rules therefore as required in the current manual of survey instructions of the United States Department of the Interior, Bureau of Land Management or by a decree of a court of law. Furthermore, that the corner points mentioned in lines 3, 4 and 5 above were, in a field survey on _____ 19____, found, recovered, restored, established or re-established as expressed below and in conformance with the rules of the Michigan State Board of Registration for Land Surveyors or, by a Decree of a Court of law:

~~A. Description of original monuments and accessories and/or subsequent restorations~~

C. (continued)

12

Set 1"x36" pipe (buried 1.0')
10" Cherry N56°W 25.60
9" Elm (in cluster of 4)
S41°W 19.00
Center N-S sand road Due E 7'
Set cedar post w/loc. tag Due W 33'
Fence to E Due S 85'±

B. Description of corner evidence found and/or method applied in restoring or re-establishing corner:

- L-12 Established center of Section 36 at intersection of $\frac{1}{4}$ lines per standard B.L.M. instructions. Corner falls 6' west of center of N-S sand road.
- L-13 Reestablished corner per standard B.L.M. instructions. Corner falls one foot west of center of N-S sand road.
- 5 Established corner per standard B.L.M. instructions.
- 12 Established corner per standard B.L.M. instructions.

C. Description of monument for corner and accessories established to perpetuate locating the position of the corner:

L-12

Set 1"x36" pipe (buried 1')
3" Maple N54°E 29.20
8" Maple N48°W 46.25
7" Cherry S69°W 31.37
Set cedar post w/loc. tag
Due E 33'
fence to E. Due S 67'±

L-13

Set std. Wexford Co. mon.
(buried 0.5')
4" Twn. Maple S48°W 43.2
6" Maple S39°E 47.7
6" Maple N45°E 54.6
set cedar post w/loc. tag
Due E 33'
Fence remains (down) to E.
Due S 56'±

5

Set 1"x36" pipe (buried 1')
17" Cherry N52°W 184.03
14" Cherry N89°W 101.04
set cedar post w/loc. tag
Due W 33'
Ctr. N-S sand road Due E 10'
Fence to E & W Due S 25'±

SIGNED BY

Carl F. Roser

DATE

7-3-74

SURVEYOR'S MICHIGAN REGISTRATION NO. 12028

FOR STATE AND UNITED STATES AGENCIES:

SIGNED BY


CHIEF OF SURVEY PARTY

DATE

APPROVED AND SIGNED BY

MICHIGAN REGISTERED LAND SURVEYOR

DATE

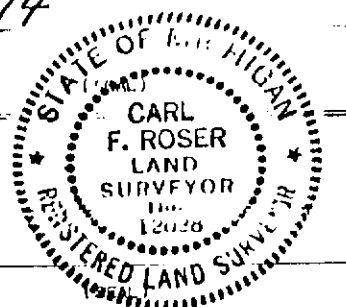

SURVEYOR'S MICHIGAN REGISTRATION NO. _____

MAYFIELD TWP.
GRAND TRAVERSE COUNTY