

MICHIGAN
DEPARTMENT OF CONSERVATION
FORESTRY DIVISION

LAND CORNER RECORD

T. 26 N.R. 9 W


GRAND TRAVERSE COUNTY

DESCRIPTION OF CORNER Sec. corner common to Sections 5 & 6 - 7 & 8

CORNER MONUMENT Set Std. Dept. Mon with Cedar Guard Post

DATE MONUMENT PLACED AND WITNESSED 12/6/68

WITNESSES TO CORNER.....

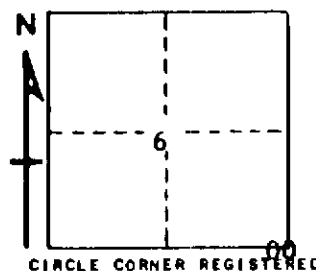

4" W. Pine	S 43 W	11.4'
9" J. Pine	N 62 W	27.0'
12" Oak	N 45 E	52.5'
AND Ctr. N-S Trail Rd.	Due W.	38'

DESCRIPTION IN DETAIL AS TO HOW CORNER WAS LOCATED AND IDENTIFIED OR RESTORED.

This corner was set for double proportion between Sec. corners, N, S. E, and M.C. to W.

E-W Rand. Due N. 74' Rand. to S. Due E. 47'

Schaaf notes (Oct. 1933) indicate he had a position for an original corner here, but he did not set a permanent point. He must have had B.T. stump sites to position his corner, but there is no evidence of B.T. site remains now. However, his tie from his random line West to the N-S Trail Road would make the position of our corner fit very reasonable.

SURVEYOR'S SEAL

SIGNED *Paul J. Boyer* DATE 1/7/69
REGISTERED LAND SURVEYOR #12028