

MICHIGAN  
DEPARTMENT OF CONSERVATION  
FORESTRY DIVISION

# LAND CORNER RECORD

T. 26 N.R. 9 W


GRAND TRAVERSE COUNTY

DESCRIPTION OF CORNER Sec. corner common to Sections 17-18-19-20

CORNER MONUMENT Found 1 1/2" pipe. Set Std. Dept. Mon with Cedar Guard Post.

DATE MONUMENT PLACED AND WITNESSED Dec. 1968

WITNESSES TO CORNER.....

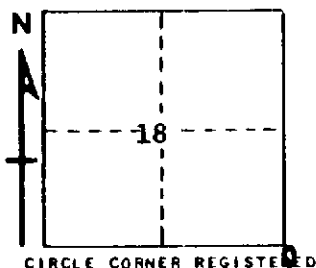

	12" R. Pine	N 45 E	21.2'
	10" R. Pine	S 65 W	61.9'
AND	10" R. Pine	S 05 W	56.9'

DESCRIPTION IN DETAIL AS TO HOW CORNER WAS LOCATED AND IDENTIFIED OR RESTORED.

This corner was found and is believed to be a perpetuation of a found Allyn corner in 1906. Schaaf had this corner in October, 1933.

SURVEYOR'S SEAL

SIGNED Carl F. Doser DATE 1/8/69  
REGISTERED LAND SURVEYOR #12028