

MICHIGAN
DEPARTMENT OF CONSERVATION
FORESTRY DIVISION

LAND CORNER RECORD

T. 26 N. R. 9 W.
T 26 N R 10 W


Grand Traverse COUNTY

DESCRIPTION OF CORNER 1/4 corner common to sections 30 - 25

CORNER MONUMENT Left 1 1/4" pipe in place.

DATE MONUMENT PLACED AND WITNESSED 8-28-63

WITNESSES TO CORNER.....

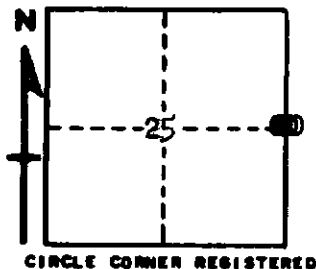

CIRCLE CORNER REGISTERED

6" R. Pine - S 23 E - 24.5

12" J. Pine - N 87 W - 69.2

AND

DESCRIPTION IN DETAIL AS TO HOW CORNER WAS LOCATED AND IDENTIFIED OR RESTORED.

This corner was found while making a survey in this section. Found 1 1/4" pipe in place at midpoint between section corners, although about 1.0 ft. off line. Best available evidence.

SURVEYOR'S SEAL

SIGNED

Kenneth D. Helling
REGISTERED LAND SURVEYOR

DATE

9/18/63