

MICHIGAN
DEPARTMENT OF CONSERVATION
FORESTRY DIVISION

LAND CORNER RECORD

T. 26 N.R. 10 W


Grand Traverse COUNTY

DESCRIPTION OF CORNER 1/4 corner common to Sections 24 - 25

CORNER MONUMENT Drove 1/2 x 1 1/4" iron bar in road.

DATE MONUMENT PLACED AND WITNESSED 8-28-63

WITNESSES TO CORNER.....

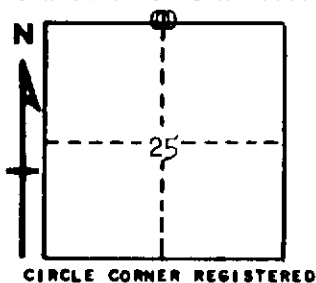

10" R. Pine - N 29 E - 37.4

8" W. Oak - S 61 E - 47.8

AND

DESCRIPTION IN DETAIL AS TO HOW CORNER WAS LOCATED AND IDENTIFIED OR RESTORED.

This corner was established by proportionate measurement midpoint on line between section corners, while making a survey of Section 25. Unable to locate anything for a previous corner.

SURVEYOR'S SEAL

SIGNED *Edward H. Stelling* #10068 DATE 9/18/63
REGISTERED LAND SURVEYOR