

MICHIGAN  
DEPARTMENT OF CONSERVATION  
FORESTRY DIVISION

# LAND CORNER RECORD

T. 27 N.R. 9 W


GRAND TRAVERSE COUNTY

DESCRIPTION OF CORNER 1/4 CORNER COMMON TO SECTIONS 28 & 29

CORNER MONUMENT Set. Std. Dept. Mon (buried) & CEDAR GUARD POST.

DATE MONUMENT PLACED AND WITNESSED 8/1/68

WITNESSES TO CORNER.....

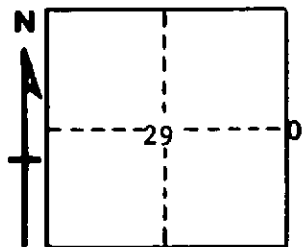

6" Oak	N 68 E	18.8'
12" Oak	S 22 E	39.9'
4" Oak	N 82 W	26.0'

AND

CIRCLE CORNER REGISTERED Center N-S Fire Lane Trail Road Due W 5.0'

DESCRIPTION IN DETAIL AS TO HOW CORNER WAS LOCATED AND IDENTIFIED OR RESTORED.

This corner was set by single proportion between sections corners to N & S.

SURVEYOR'S SEAL

SIGNED Carl F. Roer DATE 9/16/68  
REGISTERED LAND SURVEYOR #12028