

LAND CORNER RECORDATION CERTIFICATE
Filing Requirement of Act 74, Mich. P.A. 1970

For corners in
GRAND TRAVERSE

(County)	Located In:	Corner Code ##
1. Public Land Survey	T 27N R 9W	L-5, M-5, M-6
	T R	
	T R	
	T R	
2. Property Controlling in Section	S T R	
	S T R	
3. Miscellaneous Property in Sec.	S T R	
	S T R	

Register of Deeds Stamp & File Number

4. Lot No. _____, Recorded Plat _____
5. Private Claims _____

I, CARL F. ROSER, in a field survey on OCTOBER 28, 1992,
do hereby certify that under requirements of P.A. 74, Michigan P.A. of 1970, the corner points mentioned
in lines 1 and 2 above were in conformance with regulations and rules therefore as required in the
current manual of survey instructions of the United States Department of the Interior, Bureau of Land
Management or by a decree of a Court of Law and/or that the corner points mentioned in lines 3, 4 and 5
above were in conformance with the rules of the Michigan Board of Land Surveyors or by a Decree of a
Court of Law; established, re-established, monumented, re-monumented, recovered, found as
expressed below:


NOTE: Not more than 4 corners, all in the same town and range, may be recorded
on this certificate.

A. Description of original monument and accessories and/or subsequent restoration:
L-5 M-5 M-5 (CONT.)

(NO EVIDENCE OF G.L.O. CORNER, B.T.'S, LINE TREES & TOPOGRAPHY,
AS CALLED OUT IN THE G.L.O. LINE NOTES; UNLESS NOTED IN ITEM "B"
BELOW.)

	A	B	C	D	E	F	G	H	I	J	K	L	M
2	6	5	4	3	2	1							
3													
4	7	8	9	10	11	12							
5													
6	18	17	16	15	14	13							
7													
8	19	20	21	22	23	24							
9													
10	30	29	28	27	26	25							
11													
12	31	32	33	34	35	36							
13													

M-6

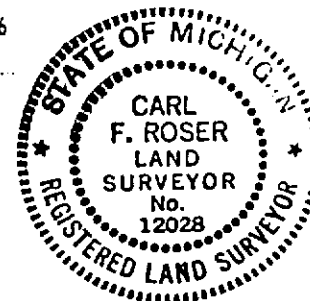

B. Description of corner evidence found and/or method applied in restoring or reestablishing corner:

L-5	M-5	M-5 (CONT.)	M-6
FD REROD FOR S 1/4 COR S-12 AS SET BY RLS, P.G. PERLA IN 1967 SUR FOR CONSUMER'S POWER CO. COR FD & ACCEPTED BY LS, W. BATZER IN 1973 SURVEY (CERT OF SURVEY L:2, PG 121). CTR OF E-W TRAIL IS 4' NORTH.	FD 1/2" REROD FOR SE COR S-12 AS SET BY P.S., R. MITCHELL IN 1985 SURVEY. MITCHELL PUT COR ON ST LINE & DOUBLE OVER FD E 1/4 COR (DNR MON) & FD S 1/8 COR (FD SLAWSON STONE) ON E LINE S-12. CTR N-S TRAIL IS 14' W. WE PULLED DNR MON (S04 07'36"E, 40.72' FROM R.M. COR) AS SET BY K.J. OSTLING IN 1967 DEPT SURVEY AT M. SCHAAF (1934) POSITION -CONT TO RIGHT	PER M.SCHAAF WIT'S. PITS & ONE POSS USBT. WE DO NOT BELIEVE M. SCHAAF HAD PROPER CORNER POSITION AND K.J.O. DID NOT FIND SLAWSON STONE 1/4 MILE TO NORTH. K.J.O. NOTED THAT DISTANCE ON W LINE S-18, T27N-R8W WAS SOMEWHAT SHORT & W LINE S-7, T27N-R8W WAS COMPARATIVELY LONG.	FD DEPT MON FOR E 1/4 COR S-13 AS SET BY K.J. OSTLING IN 1967 DEPT SURVEY AT FD 1" PIPE W/CONCRETE BASE (AS ESTABLISHED BY M. SCHAAF IN 1934.) COR IS IN APPROX INTERSEC OF TRAIL RDS (FIRE LANES) N-S-E-W.

C. Description of monument for corner and accessories established to perpetuate locating the position of the corner:

L-5	M-5	M-5 (CONT.)	M-6
FD 1/2" REROD. #16" R. OAK N50°W 40.56' #14" R. OAK N10°W 30.84' 4" BEECH S65°E 22.00' #24" R. OAK S60°W 19.55' SET CED POST W/ LOC TAG SOUTH 16.5'	FD 1/2" REROD W/RLS CAP, ADDED DNR MON & CED POST. 5" TM MAPLE N05°W 29.88' #9" B CHERRY N55°E 11.75' #11" W PINE S10°E 11.07' #24" W PINE S70°W 28.83' FD 3/4" IR ROD S00°30'E 34.60'		FD CONSERVATION DEPT MON. 5" MAPLE N60°W 22.0' #16" W PINE N50°E 15.6' 8" MAPLE S60°E 46.4' #9" R PINE S60°W 40.0' SET CED POST W/ LOC TAG. N45°W 16.5'

#RLS WM. BATZER WITS

#RLS R. MITCHELL 1985 WIT.

#RLS K. OSTLING WIT.

Signed by Carl F. Roser 12028 4-21-95 Date

Surveyor's Michigan License No. _____