

LAND CORNER RECORDATION CERTIFICATE

FILING REQUIREMENT OF ACT 74, MICH. P.A.1970

FOR CORNERS OF--	LOCATED IN--	CORNER CODE NUMBER
1. PUBLIC LAND SURVEY	T. 28 N. R. 9 W.	E-1; E-2; E-3
2. PROPERTY CONTROLLING IN SECTION	T. S. R. E. W.	
3. MISCELLANEOUS PROPERTY IN SECTION 5	T. 28 N. R. 9 W. S89°29'W, 2083.06 from E-3)	XX (U.S.M.C.,
4. LOT NO.	RECORDED PLAT	
5. PRIVATE CLAIMS		

REGISTER OF DEEDS STAMP AND FILING NUMBER

I, Carl F. Roser, do hereby certify that under requirements of P.A. 74, Michigan P.A. of 1970, the corner points mentioned in lines 1 and 2 above were, in a field survey on December 29, 19 77, established, re-established, monumented, re-monumented, recovered or restored as expressed below and in conformance with regulations and rules therefore as required in the current manual of survey instructions of the United States Department of the Interior, Bureau of Land Management or by a decree of a court of law. Furthermore, that the corner points mentioned in lines 3, 4 and 5 above were, in a field survey on December 14, 19 77, found, recovered, restored, established or re-established as expressed below and in conformance with the rules of the Michigan State Board of Registration for Land Surveyors or, by a Decree of a Court of law:

~~A. Description of original monumentation and corner points location:~~

C. (continued)

XX
Set 5/8"x40" Rerod & Sqd. Cedar Post
7" Cedar S35°W 17.78
8" Cedar N15°W 12.29
22" Hemlock N55°E 27.27
25" Stdg. Dead Elm S76°W 11.5
Approx. E shore of Petobego Lake
Due W 83'±

B. Description of corner evidence found and/or method applied in restoring or re-establishing corner:

- E-1 Fd. 3/4" pipe in mon. box that fits Steele survey (1894) very reasonable. Corner is in approximate center of E-W b'top road 3'± E of Center gravel road to S & in line with old fence tree row to N.
- E-2 Fd. 3/4" pipe that fits Steele survey (1894) very reasonable.
- E-3 Fd. 5/8" rerod that fits position as restored by Gourdie-Fraser from Tuller & Steele survey's, N-S & E.
- XX Restored Geo. Steele (1894) perpetuation of U.S.M.C. on east side of Petobego Lake on sec. line bet. Secs. 5 & 8; per Steele's elm wit., SW. Corner falls in old E-W fence. Steele's notes indicate he restored the U.S.M.C. from one Govt. B.T., rotten but with marks.

C. Description of monument for corner and accessories established to perpetuate locating the position of the corner:

E-1	E-2	E-3
Fd. 3/4" pipe in mon. box	Found 3/4" Pipe	Found 5/8" Rerod
P. Pole N25°E 67.95	26" Maple N05°W 204.75	T. Pole S44°E 55.70
12" Maple N06°W 31.44	6" N-S Gravel Rd. Due E 8'±	2" Cherry N48°E 83.3
P. Pole S20°E 55.23	Old fn. & berm W'ly Due S 2'±	28" Maple S12°W 173.30
		Ctr. N-S Gravel Rd.
		Due E 2'±
		Ctr. Gravel Rd. E Due N 3'±
		Old Fence to W Due S 2'±

SIGNED BY Carl F. Roser 4-10-78 DATE

SURVEYOR'S MICHIGAN REGISTRATION NO. 12028


FOR STATE AND UNITED STATES AGENCIES:

SIGNED BY _____ DATE

CHIEF OF SURVEY PARTY

APPROVED AND SIGNED BY _____ DATE

MICHIGAN REGISTERED LAND SURVEYOR

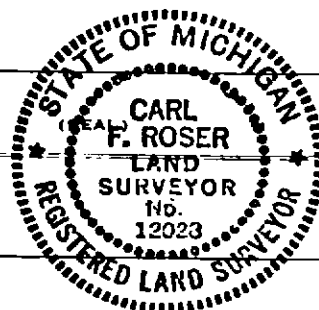

(SEAL)

SURVEYOR'S MICHIGAN REGISTRATION NO. _____

WHITEWATER TOWNSHIP
GRAND TRAVERSE COUNTY