

APR 26 1996

003 649

950326

COMMISSION

LAND CORNER RECORDATION CERTIFICATE  
Filing Requirement of Act 74, Mich. P.A. 1970

STATE OF MICHIGAN  
GRAND TRAVERSE COUNTY  
RECORDED

29 DEC 95 9:52 A.M.

KARON ANDERSON  
REGISTER OF DEEDS

Register of Deeds Stamp & File Number

For corners in  
Grand Traverse  
(County)

Located In:

Corner Code --#

1. Public Land Survey

28N 10W

B-9

2. Property Controlling  
In Section

S T R

3. Miscellaneous  
Property in Sec.

S T R

4. Lot No. , Recorded Plat  
5. Private Claims

Gary G. Wilson

December 8 95

I, in a field survey on 19 do hereby certify that under requirements of P.A. 74, Michigan P.A. of 1970, the corner points mentioned in lines 1 and 2 above were in conformance with regulations and rules therefore as required in the current manual of survey instructions of the United States Department of the Interior, Bureau of Land Management or by a decree of a Court of Law and/or that the corner points mentioned in lines 3, 4 and 5 above were in conformance with the rules of the Michigan Board of Land Surveyors or by a Decree of a Court of Law; established, re-established, monumented, re-monumented, recovered, found as expressed below:

NOTE: Not more than 4 corners, all in the same town and range, may be recorded on this certificate.

A. Description of original monument and accessories and/or subsequent restoration:

B-9 1/4 Corner common to Sections 19 & 30

Stone with "x" referenced in: Liber 2; Liber 9, Page 20; Liber 7, Page 146.  
County Surveyor records: Liber 10, Page 112; Liber 7, Page 144.  
July 1953, Sawyer found stone with "x".

B. Description of corner evidence found and/or method applied in restoring or reestablishing corner:


B-9 1/4 Corner common to Sections 19 & 30

Found rock with "x" with 3/4" pipe 0.5 ft. East.

Accepted as a careful and faithful perpetuation of the position of the original corner.

UNANIMOUSLY ACCEPTED BY THE  
GRAND TRAVERSE COUNTY PEER  
REVIEW GROUP AS THE OFFICIAL  
CORNER UNDER MICHIGAN PUBLIC  
ACT 345 OF 1990 AT A MEETING  
HELD ON 11-28-95

RFM  
ROBERT F. MITCHELL, P.S., Chairman

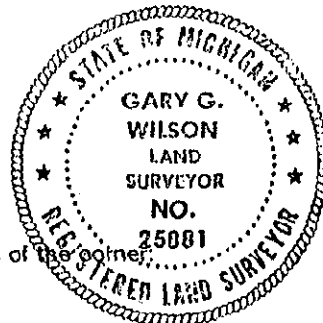

C. Description of monument for corner and accessories established to perpetuate locating the position of the corner:

B-9 1/4 Corner common to Sections 19 & 30

Perpetuated with 2-1/2" x 30" flanged bottom galvanized iron pipe with 3-1/2" brass cap stamped GRAND TRAVERSE COUNTY REMONUMENTATION.

N42°E 8.23' 12" White Pine  
N82°E 23.17' 15" White Pine  
South 5.2' Fence Post  
N25°W 16.79' 4" Wild Cherry

Corner approved by the Grand Traverse County Peer Review Group on November 28, 1995.

Signed by Gary G. Wilson  
Surveyor's Michigan License No. 25081

Date 12-27-95