

LAND CORNER RECORDATION CERTIFICATE

Authority: 1970 PA 74, MCL 54.205

Surveyor's Name: Stephan J. Szyszkoski

Field Survey Date: November 1, 2016

For corner(s) in: Houghton County

Original Public Land Survey Corner


Corner Code

S T R
S T R
S T R
S T R

Property Corner

1/16 Corner Code

a. S 18 T 51N R 35W 16 (GCDB 160400)
a. S 19 T 51N R 35W 2 (GCDB 160400)
b. S 16 T 51N R 35W P.O.L. btwn #12 & #14
S T R

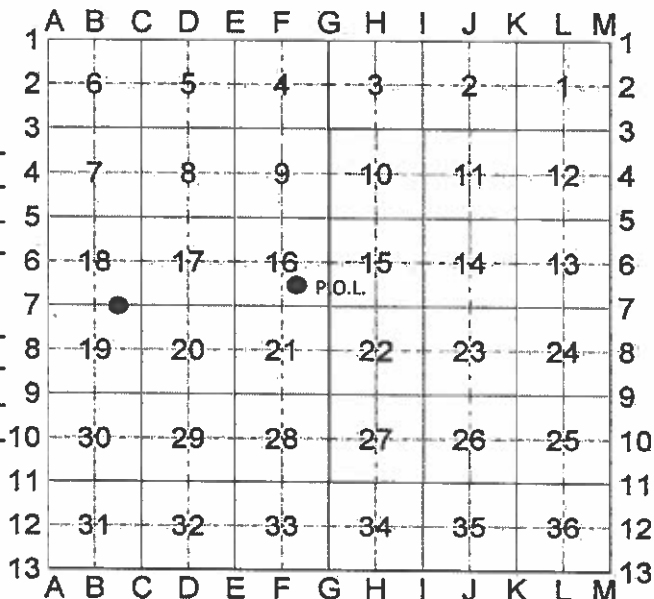

Part A. Corner History

a.) East 1/16 corner between Sections 18 and 19. Not previously monumented.

b.) Point on Line (P.O.L.). A point of convenience on the South 1/16 line of Section 16 between 1/16 corners #12 and #14, near the southerly bank of the Otter River. 1/16 corner #12 is not monumented.

Part B: Surveyor's Report on Perpetuation, Restoration, Reestablishment, or Monumentation of Corner

a.) Established the position for the corner midway and on the Section line between Section corner 1332.47' east and Quarter corner 1332.47' west.

b.) Established the position for the corner on the South 1/16 line of Section 16, the position of which line was determined by the normal protraction of a regular section, 395.85' east of the position for 1/16 corner #12 and 2229.39' west of the monumented 1/16 corner #14. This position is one of convenience, being useful to current MDNR timber harvest operations. From the position monumented, the top of a steep bank above the Otter River is approximately 20 feet west.

Part C: Field Evidence of Perpetuation or Monumentation of Corner

(a.) Set 1"IDx28" I.pipe with 2" alum. MDNR cap.
Set measuring nail with MDNR tag in the side of:
13" Y.Birch N15°E 24.0' mrkd "1/16S BT"
24" Hemlock S34°E 39.35' do
9" Sugar S36°W 28.35' do
13" Sugar N85°W 17.15' do
Set sq'd cedar post adjacent.
E= 7863450.386 N= 226609.580

(b.) Set 1"IDx28" I.pipe with 2" alum. MDNR cap.
Set measuring nail with MDNR tag in the side of:
5" Sugar N59°E 26.45' mrkd "POL BT"
7" Maple S42°E 18.3' do
5" Sugar S03°W 24.4' do
7" Y.Birch N16°W 11.8' do
Set sq'd cedar post adjacent.
E= 7866383.736 N= 226986.210

Bearings are magnetic. Coordinates are MCS83, NAD83(2011) Epoch 2010.00, in meters.
Coordinate Reference: NGS PID RL0593, E= 7868965.488 m. N= 221669.506 m.

Stephan J. Szyszkoski

01/04/2017

Professional Surveyor's License No.: 33986

page 1 of 1

Prepared By: S.J. Szyszkoski for the Michigan Dept. of Natural Resources, 427 N. US41 Baraga, MI 49908

