

LAND CORNER RECORDATION CERTIFICATE

Authority: 1970 PA 74, MCL 54.205

Surveyor's Name: Stephan J. Szyszkoski

Field Survey Date: 07/07/2016

For corner(s) in: Houghton County

Original Public Land Survey Corner

Corner Code


S T R
S T R
S T R
S T R

Property Corner

1/16 Corner Code

a. S 4 T 51N R 36W
a. S 9 T 51N R 36W
S T R
b. S 4 T 51N R 36W

15 (GCDB 320600)
1 (GCDB 320600)
12 (GCDB 340620)

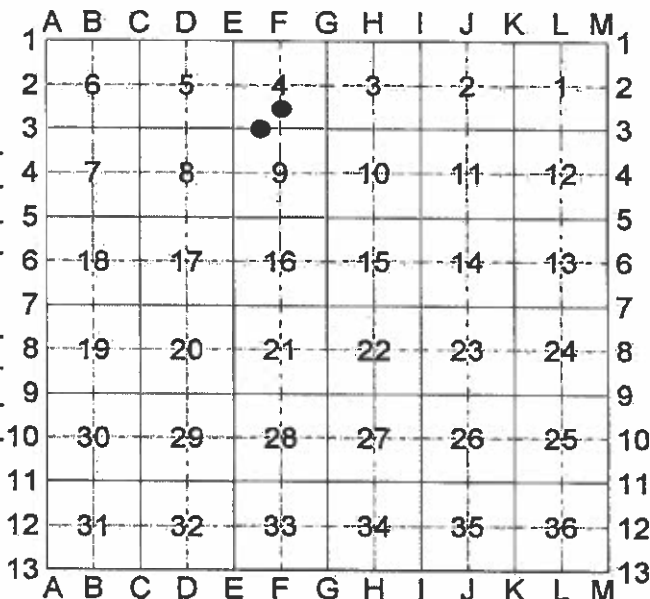

Part A. Corner History

a.) West 1/16 corner between Sections 4 and 9. Not previously monumented.

b.) Center-South 1/16 corner, Section 4. Not previously monumented.

Part B: Surveyor's Report on Perpetuation, Restoration, Reestablishment, or Monumentation of Corner

a.) Established the position for the corner midway and on the Section line between Section corner 1186.66' west and 1/4 corner 1186.66' east.

b.) Established the position for the corner midway and on a straight line between Center of Section 1218.24' north and Quarter corner 1218.24' south.

Part C: Field Evidence of Perpetuation or Monumentation of Corner

(a.) Set 1"IDx28" I.pipe with 2" alum. MDNR cap.
Set measuring nail with MDNR tag in the side of:
3" Y.Birch N02°E 6.0' mrkd "1/16S BT"
7" Maple S30°E 9.1' do
5" Maple S20°W 14.2' do
17" Sugar S81°W 7.55' do
Set sq'd cedar post adjacent.
E= 7856158.072 N= 229991.941

(b.) Set 1"IDx28" I.pipe with 2" alum. MDNR cap.
Set measuring nail with MDNR tag in the side of:
5" Sugar North 14.95' mrkd "1/16S BT"
12" Sugar S77°E 11.95' do
7" Maple N87°W 8.5' do
4" Sugar N24°W 11.1' do
Set sq'd cedar post adjacent.
E= 7856556.844 N= 230388.625

Bearings are magnetic. Coordinates are MCS83, NAD83(2011) Epoch 2010.00, in meters.
Coordinate Reference: NGS PID RL0593, E= 7868965.488 m. N= 221669.506 m.

Stephan J. Szyszkoski

09/07/2016

Professional Surveyor's License No.: 33986

page 1 of 1

Prepared By: S.J. Szyszkoski for the Michigan Dept. of Natural Resources, 427 N. US41 Baraga, MI 49908

