

LAND CORNER RECORDATION CERTIFICATE  
Filing Requirement of Act 74, Mich. P.A. 1970

For corners in

Houghton

(County)

Located In:

Corner Code #

1. Public Land Survey

T 51N R 36W

A8

T 51N R 36W

A7

T R

T R

2. Property Controlling  
in Section

S

T R

S

T R

3. Miscellaneous  
Property in Sec.

S

T R

S

T R

Register of Deeds Stamp & File Number

4. Lot No. , Recorded Plat

5. Private Claims

A7 Sep 22 2004

A8 Sep 15 2004

I, Stephan J. Szyszkoski, in a field survey on                     , 20     do hereby state that under requirements of P.A. 74, Michigan P.A. of 1970, the corner points mentioned in lines 1 and 2 above were in conformance with regulations and rules therefore as required in the current manual of survey instructions of the United States Department of the Interior, Bureau of Land Management or by a decree of a Court of Law and /or that the corner points mentioned in lines 3, 4 and 5 above were in conformance with the rules of the Michigan Board of Land Surveyors or by a Decree of a Court of Law; established, re-established, monumented, recovered, found as expressed below:

NOTE: Not more than 2 corners, all in the same town and range, may be recorded on this certificate.

	A	B	C	D	E	F	G	H	I	J	K	L	M
1													
2		6		5		4		3		2		1	
3													
4		7		8		9		10		11		12	
5													
6		18		17		16		15		14		13	
7													
8		19		20		21		22		23		24	
9													
10		30		29		28		27		26		25	
11													
12		31		32		33		34		35		36	
13													

A. Description of original monument and accessories and/or subsequent restoration:

(A8) Quarter Corner common to Section 24 T51N-R37W Ontonagon County, and Section 19 T51N-R36W Houghton County. Reestablished by proportionate measurement in 1992 by the undersigned. Set 1"x36" I.pipe with 4" alum. MDNR cap. 8" Hemlock S44W 18.1', 12" Hemlock S40E 11.2', 5" Hemlock N85W 5.5', 7" Hemlock N26E 20.0'.

(A7) Section corner common to 13-24, T51N-R37W Ontonagon Co., and 18-19 T51N-R36W Houghton Co. Remonumented in 1958 from two probable BTs by Billy D. Buckler RLS. Set 1" pipe with 4" brass cap. 16" Hard Maple N41E 60 links, 14" Hard Maple N27W 45 links, 11" Hard Maple S26W 60 links.

B. Description of corner evidence found and/or method applied in restoring or reestablishing corner:


(A8) Recovered the 1992 monument in good condition and at record bearing and distance from the NBTs NE, SE, and SW. Scribing visible on all. The NBT S40E was misidentified in the 1992 record and is actually a Maple. Made one new witness.

(A7) Recovered the 1958 monument in good condition and at record bearing and distance from the 1958 witnesses. The Hard Maple NBTs SW and NW are in good condition with overgrown blazes. The NBT NE is now a rotting stump. Also recovered, at record bearing and distance, the chopped-out Maple, noted in the 1958 survey as probably being an original BT.

C. Description of monument for corner and accessories established to perpetuate locating the position of the corner:

(A8) Found 1"ID I.pipe with 4" alum. MDNR cap. Set measuring nails in the following blazed and scribed trees:  
8" Hemlock N26E 20.3' old scribing  
13" Maple S40E 11.6' do  
8" Hemlock S44W 18.4' do  
7" Hemlock N42W 6.6' "1/4S NBT"  
Bearings are magnetic. Distances are to nail with tag. Sq'd cedar post and metal fence post adjacent.

(A7) Found 1"ID I.pipe with 4" brass MI Dept of Conservation cap. Set measuring nails in the following marked trees:  
5" Sugar N79E 28.3' "S13 NBT"  
7" Hemlock S20E 28.8' "S19 NBT"  
22" Maple S33E 21.8' old chopped blaze  
16" Sugar S29W 39.7' overgrown blazes  
16" Sugar N25W 30.3' do  
Bearings are magnetic. Distances are to nail with tag. A sq'd cedar post is adjacent.

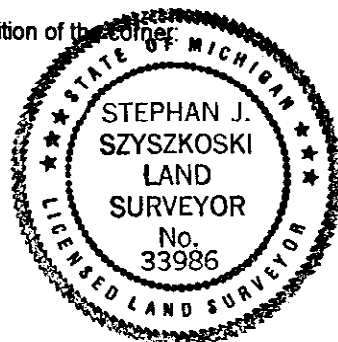

Signed by Stephan J. Szyszkoski  
Surveyor's Michigan License No. 33986

Date 11/3/04

For the Michigan Department of Natural Resources - Office of Land and Facilities

FORM APPROVED BY MICHIGAN STATE BOARD OF PROFESSIONAL SURVEYORS, JAN. 28, 1971  
REVISED MAY 14, 1975  
REVISED JAN. 1983  
REVISED OCT., 1985