

LAND CORNER RECORDATION CERTIFICATE  
Filing Requirement of Act 74, Mich. P.A. 1970 as Amended

For corners in

Houghton

(County)

Located In:

Corner Code #

1. Public Land Survey

T 52N R 35W

C3

T R

T R

S T R

2. Property Controlling  
in Section

S 6 T 52N R 35W

1

S T R

3. Miscellaneous

S T R

Property in Sec.

S T R

4. Lot No. , Recorded Plat

5. Private Claims

C3 Jun 13 2007

1 Jun 12 2007

I, Stephan J. Szyszkoski, in a field survey on \_\_\_\_\_, 20\_\_\_\_ do hereby state that under requirements of P.A. 74, Michigan P.A. of 1970, the corner points mentioned in lines 1 and 2 above were in conformance with regulations and rules therefore as required in the current manual of survey instructions of the United States Department of the Interior, Bureau of Land Management or by a decree of a Court of Law and /or that the corner points mentioned in lines 3, 4 and 5 above were in conformance with the rules of the Michigan Board of Land Surveyors or by a Decree of a Court of Law; established, re-established, monumented, recovered, found as expressed below:

NOTE: Not more than 2 corners, all in the same town and range, may be recorded on this certificate.

A. Description of original monument and accessories and/or subsequent restoration:

(C3) Corner common to Sections 5-6-7-8. 1957 - Corner reestablished by Billy D. Buckler RLS by measurement to streams north and west, calls of field notes to west, numerous blazes in vicinity, and at record bearing and distance from two spruce stumps [possible original BTs Spruce 10 N80E 27 links, Spruce 8 S63W 62 links] with no markings visible. Mr. Buckler set 1" pipe with 4" brass cap and marked: 8" W.Pine S65W 13 links, 14" Hemlock N18W 61 links.

(1-Sec. 6) West 1/16 corner on the north line of Sec. 6. Not established in the original survey. The original GLO plat of T52N-R35W gives distances of 21.41 chains west to the Township corner and 20.00 chains east to the 1/4 corner on the north side of Sec. 6.

B. Description of corner evidence found and/or method applied in restoring or reestablishing corner:

(C3) Found the 1957 monument in good condition and at record bearing and distance from the 1957 witnesses. The W.Pine NBT is a cut and rotting stump, the Hemlock is in good condition. Accepted the monument as a careful and faithful reestablishment of the position of the original corner.

(1-Sec. 6) Established the corner on the Township line at 1415.73' east of the Township corner and 1322.50' west of the N1/4 corner of Sec. 6, being proportionated to the original GLO record.

C. Description of monument for corner and accessories established to perpetuate locating the position of the corner:

(C3) Found 1" ID I.pipe with 4" brass MI

Dept. of Conservation cap. Set

measuring nails in:

18" Hemlock N15W 40.7' old blazes \*

9" Maple S16E 13.8' mrkd "S8 NBT"

8" Sugar S21W 22.8' "S7 NBT"

11" Hemlock S89W 8.6' "S7 NBT"

Set sq'd Hemlock post adjacent.

Bearings are magnetic. Distances are to nail with MDNR tag.

(1) Set 1" IDx32" I.pipe with 4" alum.

MDNR cap. Set measuring nails in:

7" Balsam N02E 5.8' mrkd "1/16S BT"

6" Balsam S32E 3.5' do

5" B.Ash N75W 4.3' do


7" B.Ash N25W 16.8' do

Distances are to nail with MDNR tag.

East 5.26' MDNR mon. at 1/16 cor. for

Sec. 31 T53N-R35W. North, 0.9' Fd.

1.25" ID I.pipe. Bearings are magnetic.

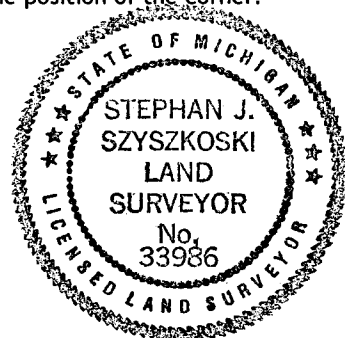

Signed by

*Stephan J. Szyszkoski*

Date

7/12/07

Surveyor's Michigan License No.

33986

For the Michigan Department of Natural Resources, Office of Land and Facilities