

LAND CORNER RECORDATION CERTIFICATE  
Filing Requirement of Act 74, Mich. P.A. 1970

SURVEY &  
REMONUMENTATION

DEC 14 1998

Nov. 6, 1998  
Robert W. Crampton  
For corners in  
HOUGHTON  
(County)

Located In:

Corner Code #

SECTION

1. Public Land Survey T 53W R 33W  
T \_\_\_\_\_ R \_\_\_\_\_  
T \_\_\_\_\_ R \_\_\_\_\_  
T \_\_\_\_\_ R \_\_\_\_\_  
2. Property Controlling S \_\_\_\_\_ T \_\_\_\_\_ R \_\_\_\_\_  
in Section S \_\_\_\_\_ T \_\_\_\_\_ R \_\_\_\_\_  
3. Miscellaneous S \_\_\_\_\_ T \_\_\_\_\_ R \_\_\_\_\_  
Property in Section S \_\_\_\_\_ T \_\_\_\_\_ R \_\_\_\_\_

MEANDER-11

Sec. 1

ROBERT F. MIKESCH 11/16/98  
HOUGHTON COUNTY, REGISTER 14:46  
LC 3/ 549 PAU Fee: 9.00  
Page 1 of 1

Register of Deeds Stamp & File Number

4. Lot No. \_\_\_\_\_, Recorded Plat \_\_\_\_\_  
5. Private Claims \_\_\_\_\_

	A	B	C	D	E	F	G	H	I	J	K	L	M
2	6		5		4		3		2		1		
3													
4	7		8		9		10		11		12		
5													
6	16		17		16		15		14		13		
7													
8	19		20		21		22		23		24		
9													
10	30		29		28		27		26		25		
11													
12	31		32		33		34		35		36		
13													

I, R.W. CRAMPTON, in a field survey on OCTOBER 5, 19 98  
do hereby certify that under requirements of P.A. 74, Michigan P.A. of 1970, the corner points mentioned  
in lines 1 and 2 above were in conformance with regulations and rules therefore as required in the current  
manual of survey instructions of the United States Department of the Interior, Bureau of Land  
Management or by a decree of a Court of Law and/or that the corner points mentioned in lines 3, 4 and  
5 above were in conformance with the rules of the Michigan Board of Professional Surveyors or by a  
Decree of a Court of Law; established, re-established, monumented, re-monumented, recovered, found  
as expressed below:

NOTE: Not more than 4 corners, all in the same town and range, may be recorded  
on this certificate.

A. Description of original monument and accessories and/or subsequent restoration:


MEANDER-11 SET MEANDER POST ON RIGHT BANK IN MARCH NO BEARING TREE

B. Description of corner evidence found and/or method applied in restoring or reestablishing corner:

MEANDER-11, SET 1 1/4" IRON PIPE WITH 2 1/4" BRASS CAP ON LINE BETWEEN THE MEANDER CORNER ON  
THE SOUTH SIDE OF PORTAGE CANAL AND A 5/8" IRON ROD IN OLD FENCE LINE ON W LINE  
OF SECTION 12, S01°53'30"E 573.61' FROM NW CORNER OF SECTION 12, 64' TO WATER'S EDGE.  
53' TO WEST OLD FENCE.

C. Description of monument for corner and accessories established to perpetuate locating the position of the corner:

MEANDER-11 THE 1 1/4" IRON PIPE WITH BRASS CAP WAS WITNESSED WITH SURVEY TAG NAILED TO:  
24" PINE TREE N69°W 35.44', 12" MAPLE TREE N67°E 62.20',  
10" MAPLE TREE S66°E 54.71', 30" PINE TREE S26°W 35.54'.

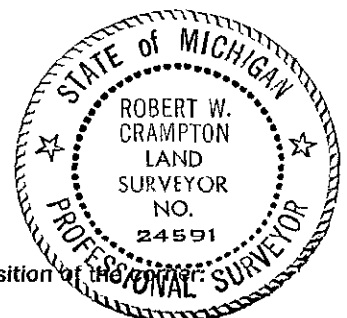

Signed by Robert W. Crampton  
Surveyor's Michigan License No. 24591

Date Nov. 4, 1998