

LAND CORNER RECORDATION CERTIFICATE  
Filing Requirement of Act 74, Mich. P.A. 1970 as Amended

For corners in

Houghton (County)	Located In:	Corner Code #
1. Public Land Survey	T R	
	T R	
	T R	
2. Property Controlling in Section	S 8 T 55N R 33W	12
	S 11 T 55N R 33W	16
	S T R	
3. Miscellaneous Property in Sec.	S T R	
	S T R	
4. Lot No. _____, Recorded Plat _____		
5. Private Claims _____		

Register of Deeds Stamp & File Number

1	A	B	C	D	E	F	G	H	I	J	K	L	M
2	6	5	4	3	2	1							
3													
4	7	8	9	10	11	12							
5													
6	18	17	16	15	14	13							
7													
8	19	20	21	22	23	24							
9													
10	30	29	28	27	26	25							
11													
12	31	32	33	34	35	36							
13													

I, Stephan J. Szyszkoski, in a field survey on 12 06/16/2011  
16 07/26/2011 do hereby state  
that under requirements of P.A. 74, Michigan P.A. of 1970, the corner points mentioned in lines 1 and 2  
above were in conformance with regulations and rules therefore as required in the current manual of survey  
Instructions of the United States Department of the Interior, Bureau of Land Management or by a decree of  
a Court of Law and /or that the corner points mentioned in lines 3, 4 and 5 above were in conformance with  
the rules of the Michigan Board of Land Surveyors or by a Decree of a Court of Law; established, I  
re-established, monumented, recovered, found as expressed below:

NOTE: Not more than 2 corners, all in the same town and range, may be recorded  
on this certificate.

A. Description of original monument and accessories and/or subsequent restoration:

(12-Sec. 8) South 1/16 corner, Section 8. Corner previously monumented in 1998 and recorded by  
S.C.Hein PS32336 and described in L3 of LCR P575.

(16-Sec. 11) East 1/16 corner between Sections 11 and 14. Not previously established.

B. Description of corner evidence found and/or method applied in restoring or reestablishing corner:

(12-Sec. 8) The 1998 position for this corner was controlled by a reestablishment of Quarter corner  
D5 in 1997 which was not adopted by the Houghton County Remonumentation Peer Review Group in 2001. I  
established the position for the corner in accord with control approved by Houghton County  
Remonumentation, midway and on a straight line between Center of Section 8 (L3 - P574) 1289.96' north  
and Quarter corner D5 (L4 - P255) 1289.96' south. The position for D5 was computed from the County  
Remonumentation survey as recorded in L3 of plats Page 298B. From the position thus established, I  
found the 1/16 corner monument of record N 38 deg. 45'E (MCS83 grid bearing) 4.03' distant, in good  
condition.

(16-Sec. 11) Established the corner midway and on the Section line between Quarter corner 1326.53'  
west and Section corner 1326.53' east.

C. Description of monument for corner and accessories established to perpetuate locating the position of the corner:


(12) Set 1"IDx32" I.pipe with 4" alum. MDNR cap.  
Set measuring nail with MDNR tag in the side of:  
5" twin Sugar N81E 19.3' mrkd "1/16S BT"  
5" Sugar S55E 24.5' do  
4" Sugar S50W 15.25' do  
6" Sugar N58W 5.25' do  
3/4" capped pipe N45E 4.03'  
Bearings are magnetic.  
Set sq'd cedar post adjacent.

(16) Set 1"IDx32" I.pipe with 4" alum. MDNR cap.  
Set measuring nail with MDNR tag in the side of:  
8" Sugar N07E 16.85' mrkd "1/16S BT"  
6" Sugar S88E 5.65' do  
10" Sugar S23E 22.4' do  
13" Sugar N70W 6.25' do  
Set sq'd cedar post adjacent.  
Bearings are magnetic.

Signed by Stephan J. Szyszkoski  
Surveyor's Michigan License No. 33986

Date 09/28/2011

For the Michigan Department of Natural Resources, Forest Management Division

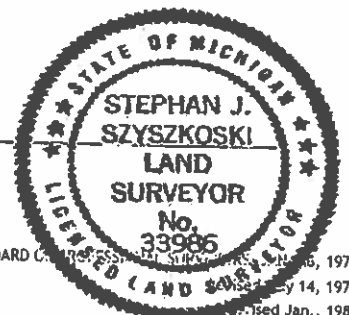

16736

16737