

LAND CORNER RECORDATION CERTIFICATE
Filing Requirement of Act 74, Mich. P.A. 1970 as Amended

For corners in

Houghton (County)	Located In:	Corner Code #
1. Public Land Survey	T _____ R _____	_____
	T _____ R _____	_____
	T _____ R _____	_____
2. Property Controlling in Section	S 8 T 55N R 33W	Ref cor 12-D5
	S 8 T 55N R 33W	C-E-SW 1/64
	S _____ T _____ R _____	_____
3. Miscellaneous Property in Sec.	S _____ T _____ R _____	_____
	S _____ T _____ R _____	_____
4. Lot No. _____, Recorded Plat _____		
5. Private Claims _____		

Register of Deeds Stamp & File Number

	A	B	C	D	E	F	G	H	I	J	K	L	M
1													
2	6		5		4		3		2		1		
3													
4	7		8		9		10		11		12		
5													
6	18		17		16		15		14		13		
7													
8	19		20		21		22		23		24		
9													
10	30		29		28		27		26		25		
11													
12	31		32		33		34		35		36		
13													

I, Stephan J. Szyszkoski, in a field survey on 06/15/2011 do hereby state
that under requirements of P.A. 74, Michigan P.A. of 1970, the corner points mentioned in lines 1 and 2
above were in conformance with regulations and rules therefore as required in the current manual of survey
instructions of the United States Department of the Interior, Bureau of Land Management or by a decree of
a Court of Law and /or that the corner points mentioned in lines 3, 4 and 5 above were in conformance with
the rules of the Michigan Board of Land Surveyors or by a Decree of a Court of Law; established,
re-established, monumented, recovered, found as expressed below:

NOTE: Not more than 2 corners, all in the same town and range, may be recorded
on this certificate.

A. Description of original monument and accessories and/or subsequent restoration:

(12-D5) Reference corner on the N-S 1/4 line of Section 8 at the north edge of a marsh on the east
side of Boston Pond, between 1/16 corner #12 and Quarter corner D5. Not previously established.

(C-E-SW 1/64) 1/64 corner being the SW corner of the S1/2 of the SE1/4 of the NE1/4 of the SW1/4 of
Section 8.

B. Description of corner evidence found and/or method applied in restoring or reestablishing corner:

(12-D5) Established the corner on a straight line between Center of Section 8 (L3 of LCR P574)
1689.96' north and Quarter corner D5 (L4 of LCR P255), in Boston Pond, 889.96' south.

(C-E-SW 1/64) Established the corner midway and on a straight line between 1/16 corner #11, 654.00'
west and 1/16 corner #12, 654.00' east.

C. Description of monument for corner and accessories established to perpetuate locating the position of the corner:


(12-D5) Set 1"IDx32" I.pipe w/ 4" alum. MDNR cap.
North 400.00' MDNR mon. at 1/16 corner #12
North 722.49' MDNR mon. at title corner.
Set measuring nail with MDNR tag in the side of:
10" Maple N38W 77.5' mrkd "SMC BT"
6" Maple N10W 53.45' do
9" Maple N26E 35.75' do
6" Maple S80E 57.45' do
Set sq'd cedar post adjacent.
Bearings are magnetic.

(1/64) Set 1"IDx32" I.pipe with 4" alum. MDNR cap
North 323.33' to MDNR mon. at title corner.
Set measuring nail with MDNR tag in the side of:
9" Oak N13W 24.7' mrkd "1/64S BT"
7" Sugar N82E 29.5' do
5" Maple S18W 9.0' do
6" Maple S59W 27.45' do
Set sq'd cedar post adjacent.
Bearings are magnetic.

Signed by Stephan J. Szyszkoski
Surveyor's Michigan License No. 33986

Date 10/26/2011

For the Michigan Department of Natural Resources, Forest Management Division

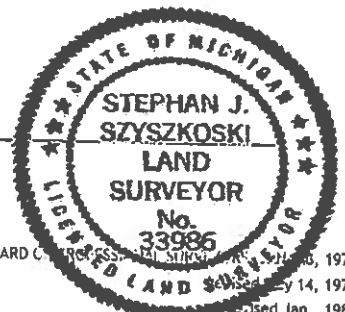

16733

16734